


TYPE "K" COPPER FOR THIS BURIED CW (5'-0" BELOW FINISHED GRADE)

NON-FREEZE GRADE HYDRANT BOX

REFER TO CIVIL DWGS FOR LOCATION OF THE PADDOCK & WATER TROUGH

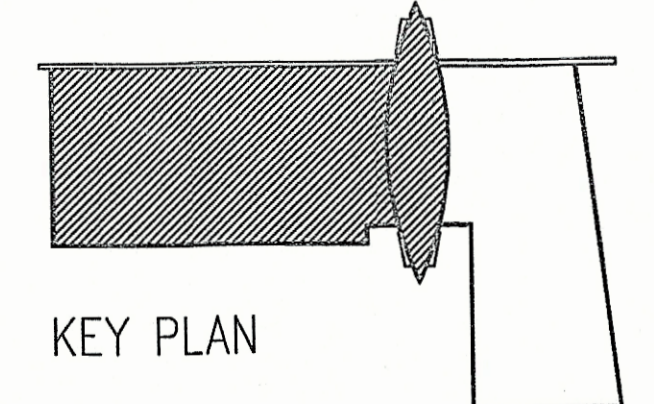


CITY OF PROVIDENCE
PUBLIC SAFETY COMPLEX
PROVIDENCE RI 02903

ARDEN
ARDEN ENGINEERING CONSULTANTS, INC.
45 PATTUCKETT BL. 02904

PSEC

TEL: (401) 727-3500
FAX: (401) 727-3540

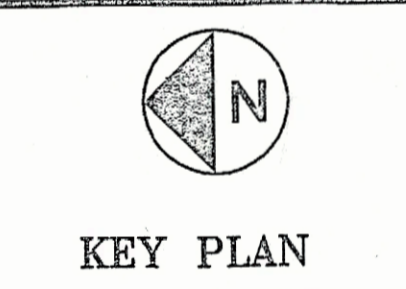

REV.	DATE	DESCRIPTION
1	04/08/02	AS-BUILT

AS-BUILT

FIRST FLOOR
POLICE
PLUMBING
CO-ORD DWG

DATE: MAR 20, 2001
SCALE: 1/8" = 1'-0"
DRAWN: []
CHECKED: []

JOB No. 875
SAP No. E-601
DRAWING No.

P-111A



SHEET 1

REV.	DATE	DESCRIPTION
1	04/08/02	AS-BUILT

FIRST FLOOR
FIRE / COURTS
PLUMBING
CO-ORD DWG
APRIL 18, 2001

JOB No. 875
SAP No. E-601
DRAWING No.

P-111B

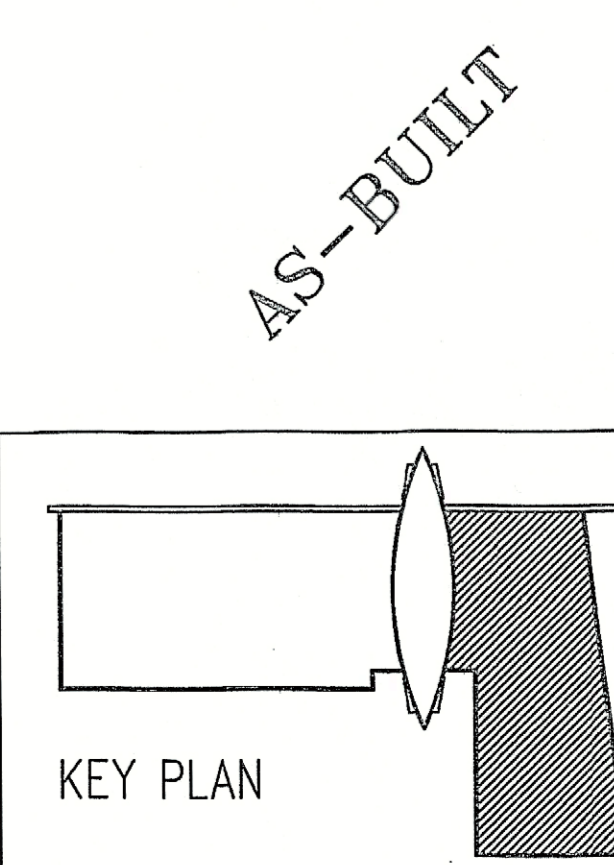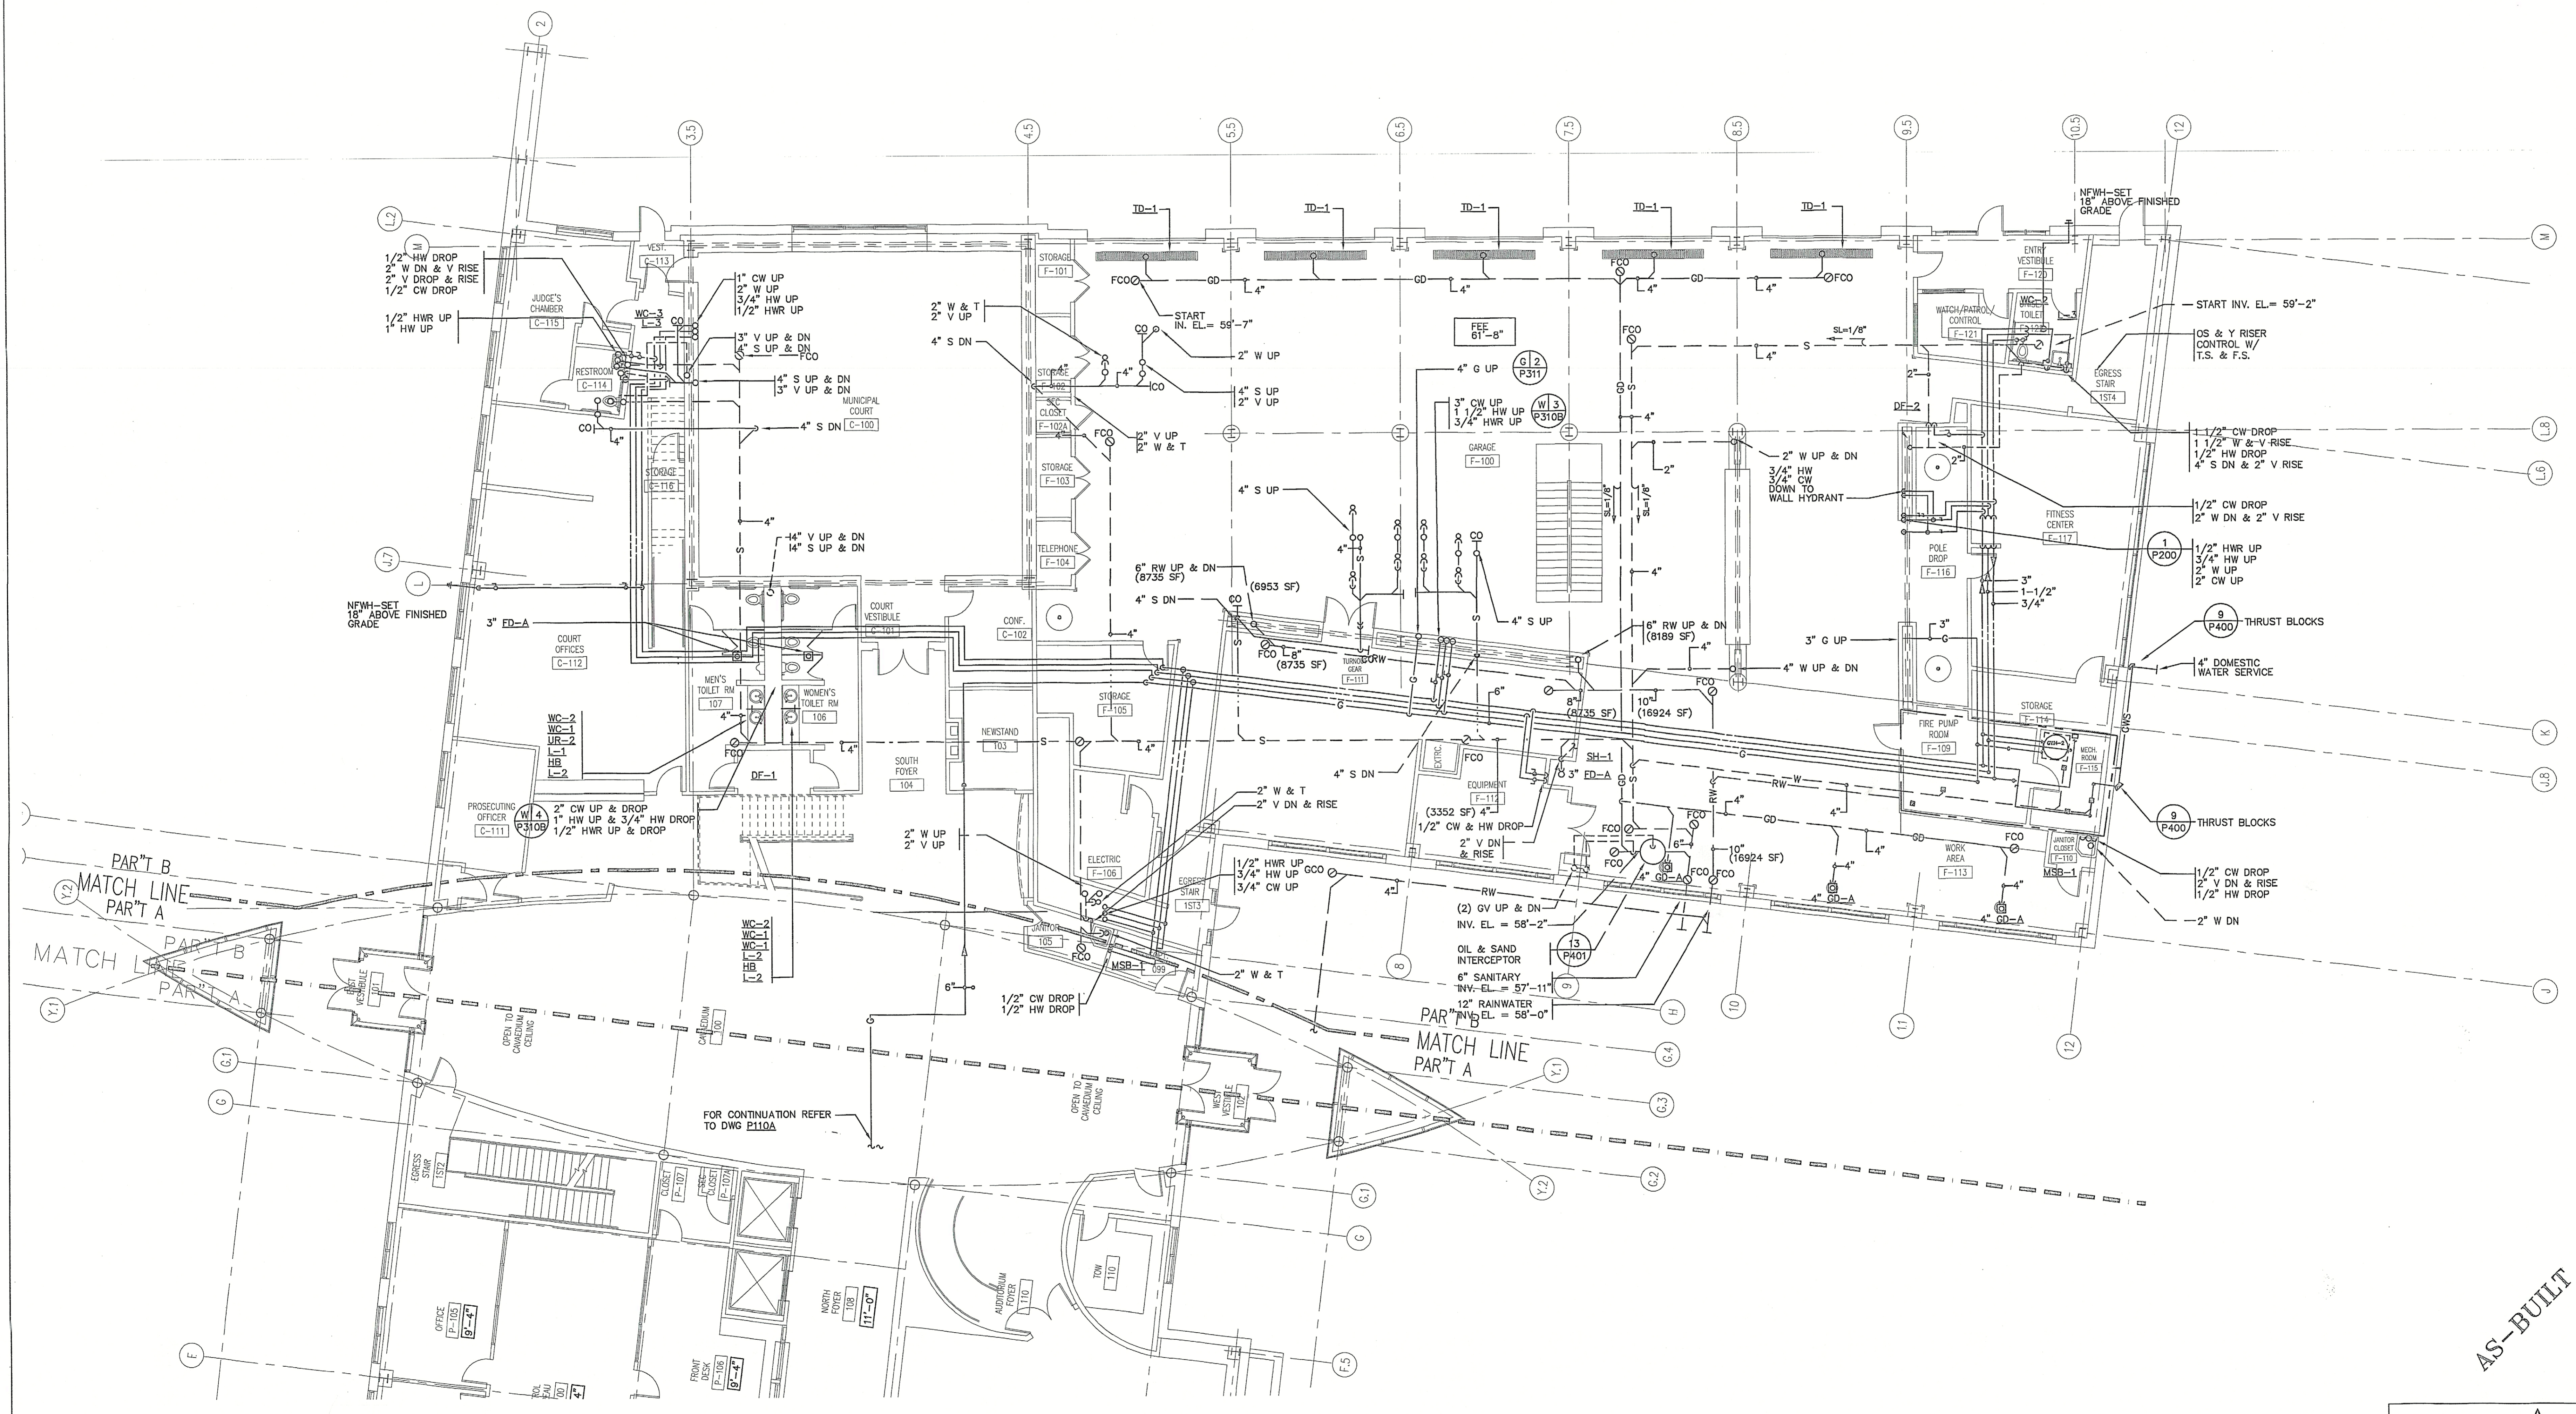

AS-BUILT

KEY PLAN




KEY PLAN

REV.	DATE	DESCRIPTION
1	04/08/02	AS-BUILT


SECOND FLOOR POLICE PLUMBING CO-ORD DWG	DATE MAR 20, 2001	SCALE 1/8" = 1'-0"	DRAWN DAW BA	CHECKED
--	----------------------	-----------------------	-----------------	---------

JOB No. 875
SAP No. E-601
DRAWING No.


P-112A

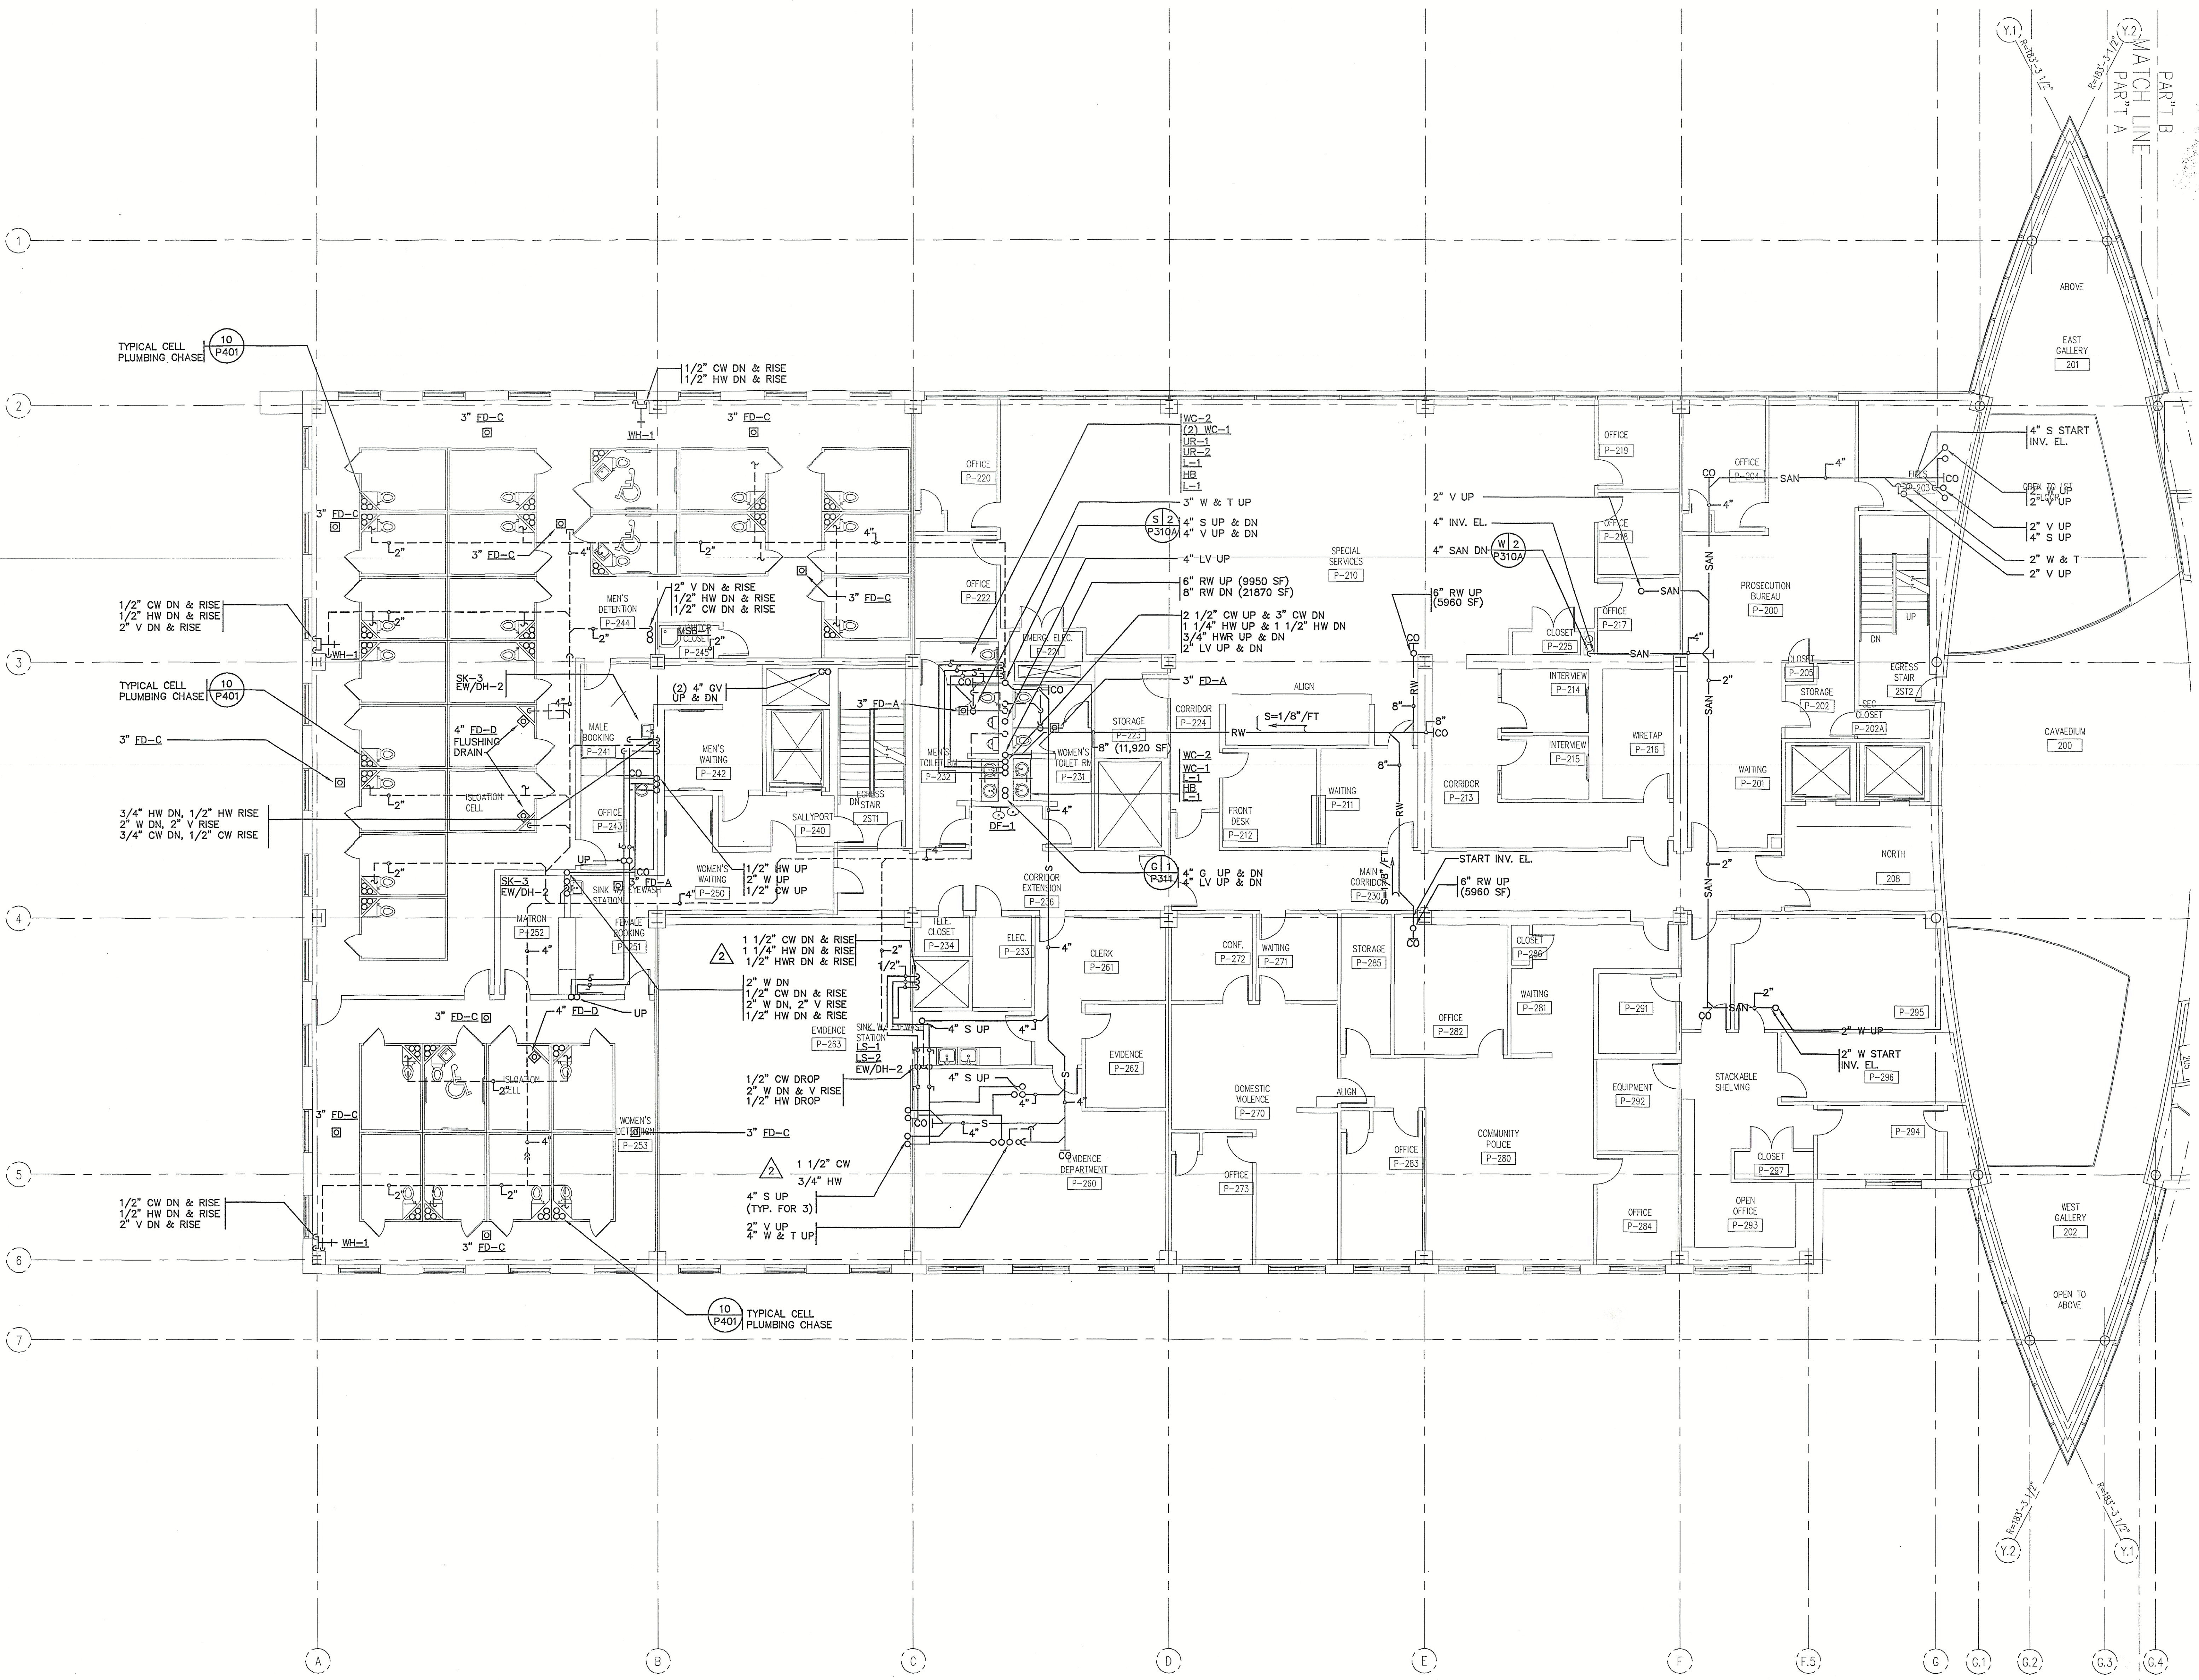

AS-BUILT

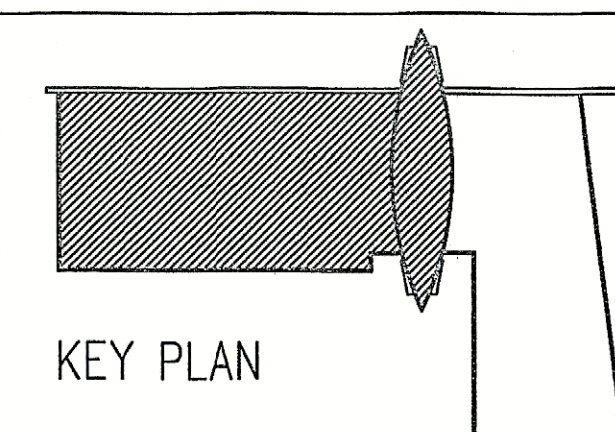

KEY PLAN

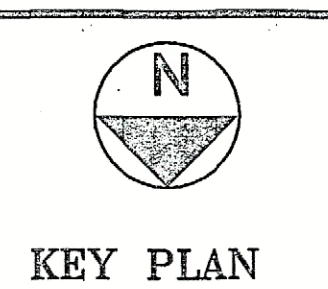


KEY PLAN

REV.	DATE	DESCRIPTION
1	04/08/02	AS-BUILT

SECOND FLOOR
FIRE / COURT
PLUMBING
CO-ORD DWG
DATE: APRIL 5, 2001
SCALE: 1/8" = 1'-0"
DRAWN: DAW RA
CHECKED:

JOB No. 875
SAP No. E-601
DRAWING No.

P-112B

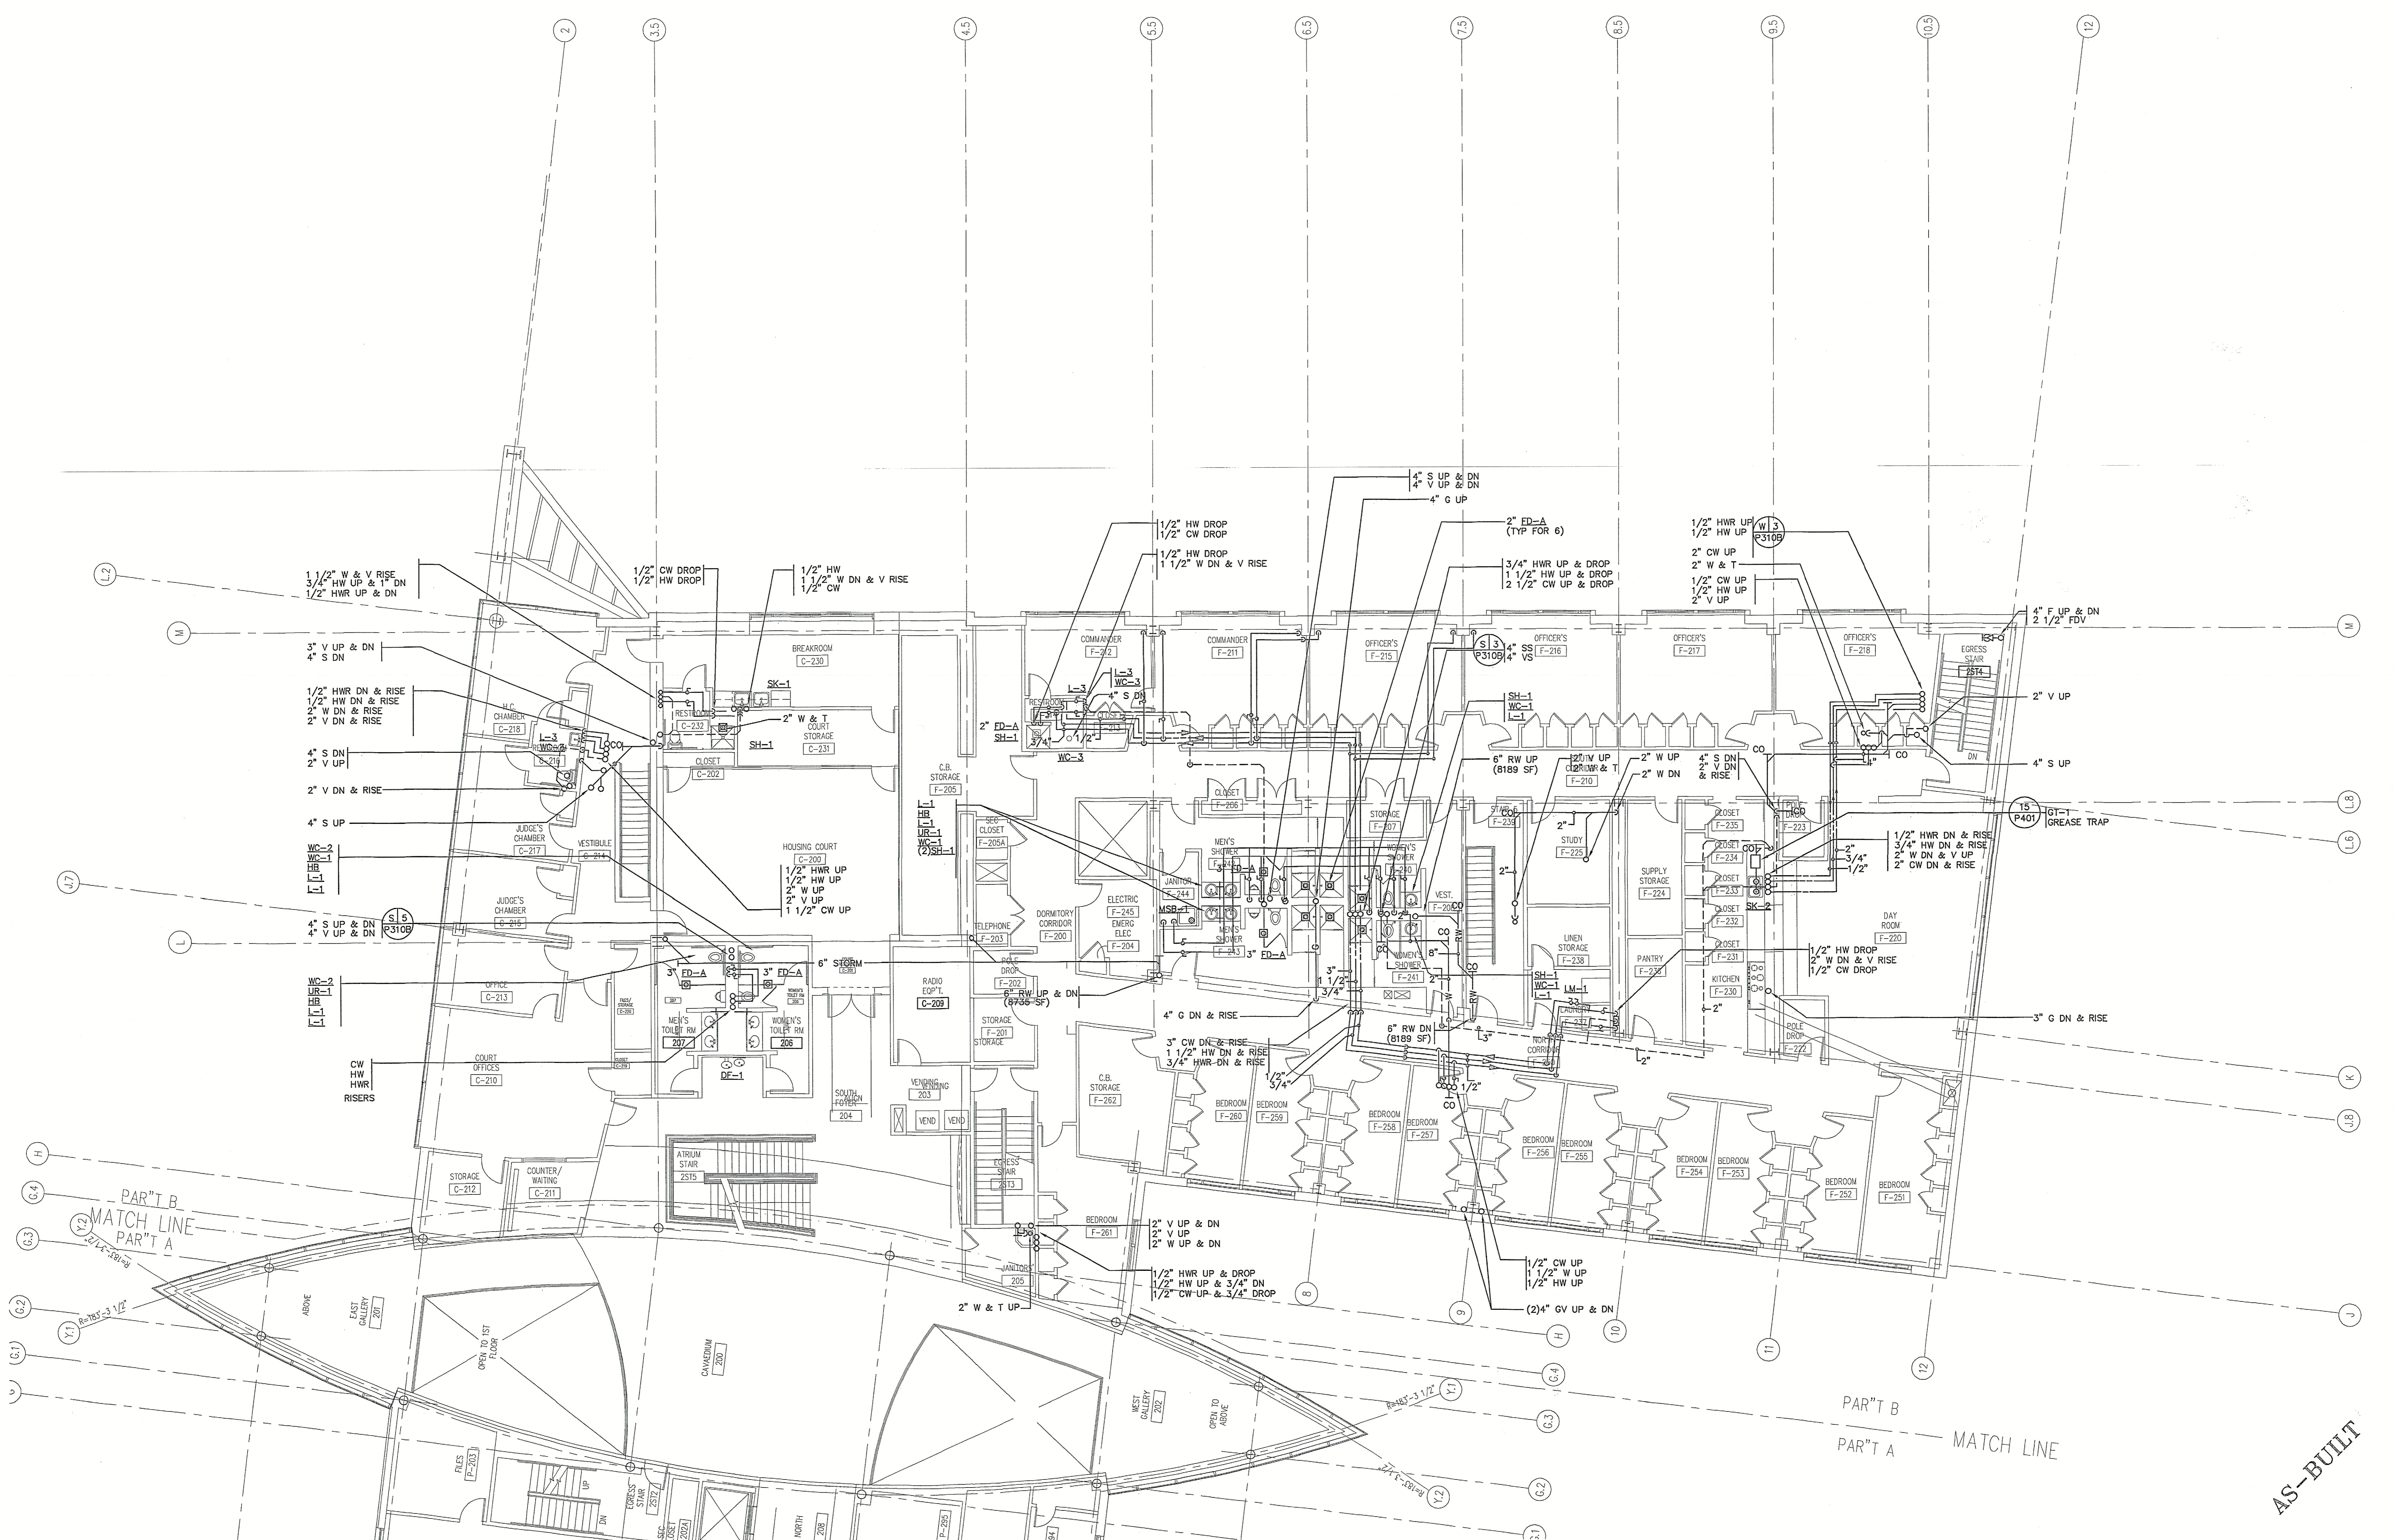

AS-BUILT

KEY PLAN





KEY PLAN

REV.	DATE	DESCRIPTION
1	04/08/02	AS-BUILT

THIRD FLOOR POLICE PLUMBING CO-ORD DWG	CHECKED	DRAWN	DATE
			MAY 19, 2001
		SCALE	
		1/4" = 1'-0"	

JOB No. 875
SAP No. E-601
DRAWING No.

P-113A

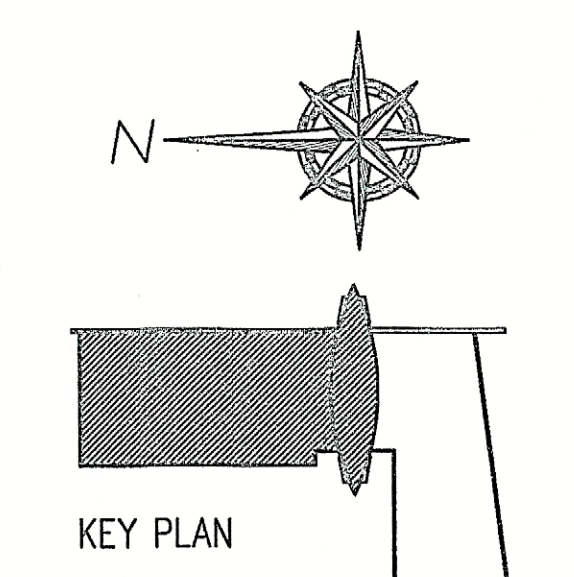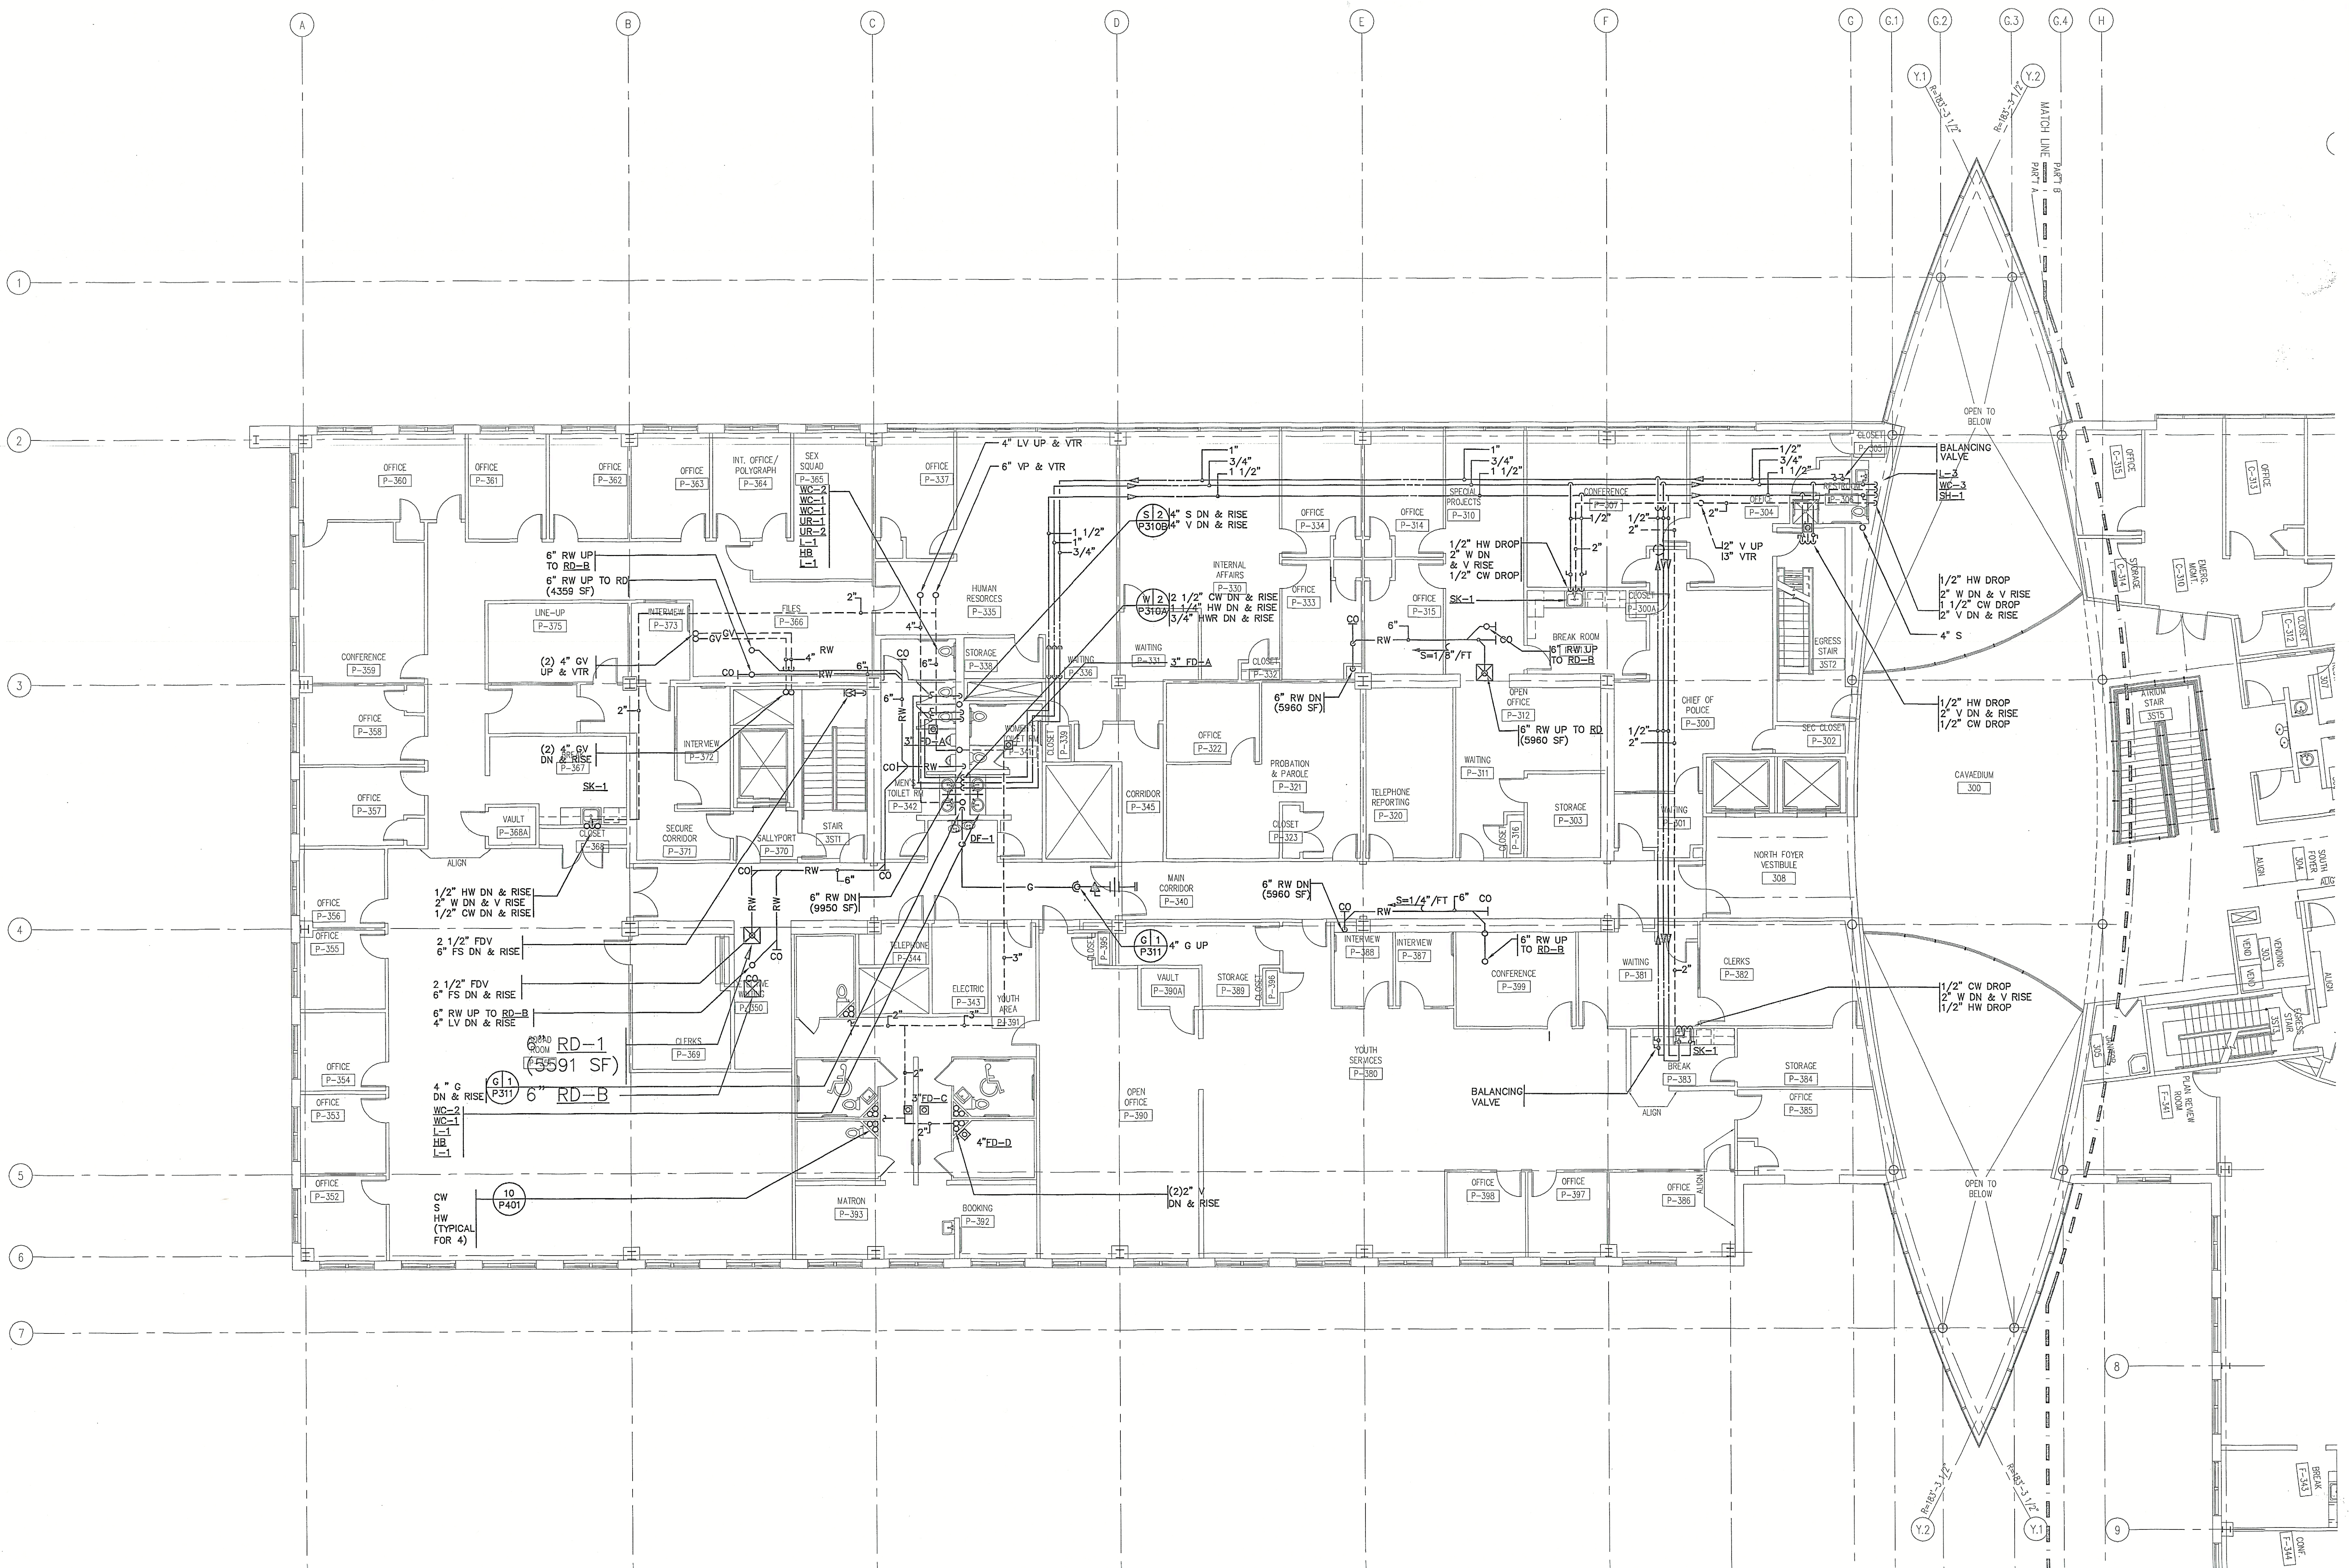

AS-BUILT




REV.	DATE	DESCRIPTION
1	04/05/02	AS-BUILT

THIRD FLOOR
FIRE/COURT
PLUMBING
CO-ORD DWG

DATE: MAR 20, 2001
SCALE: 1/4" = 1'-0"
DRAWN: DAW RA
CHECKED:

JOB No. 875
SAP No. E-601
DRAWING No.
PL-3RD-001
SHEET 1

AS-BUILT

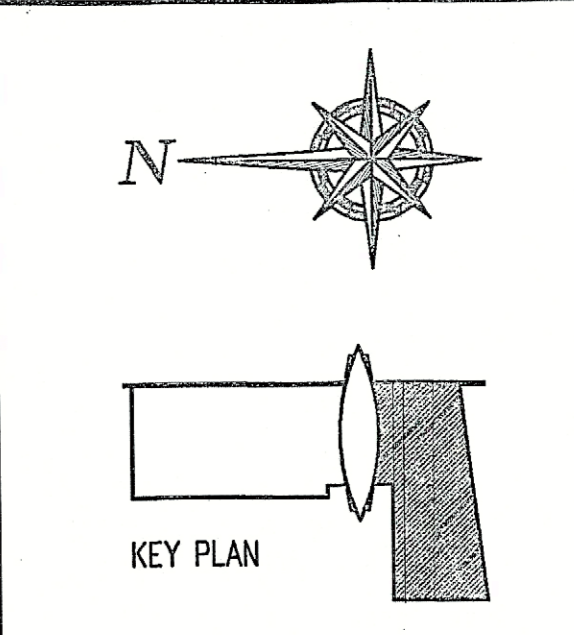


REV.	DATE	DESCRIPTION
1	04/09/02	AS-BUILT

DATE	APRIL 18, 2001
SCALE	1/8" = 1'-0"
CHECKED	
DRAWN	BY RA


JOB No. 875
SAP No. E-601
DRAWING No.

H-110A


SHEET 1

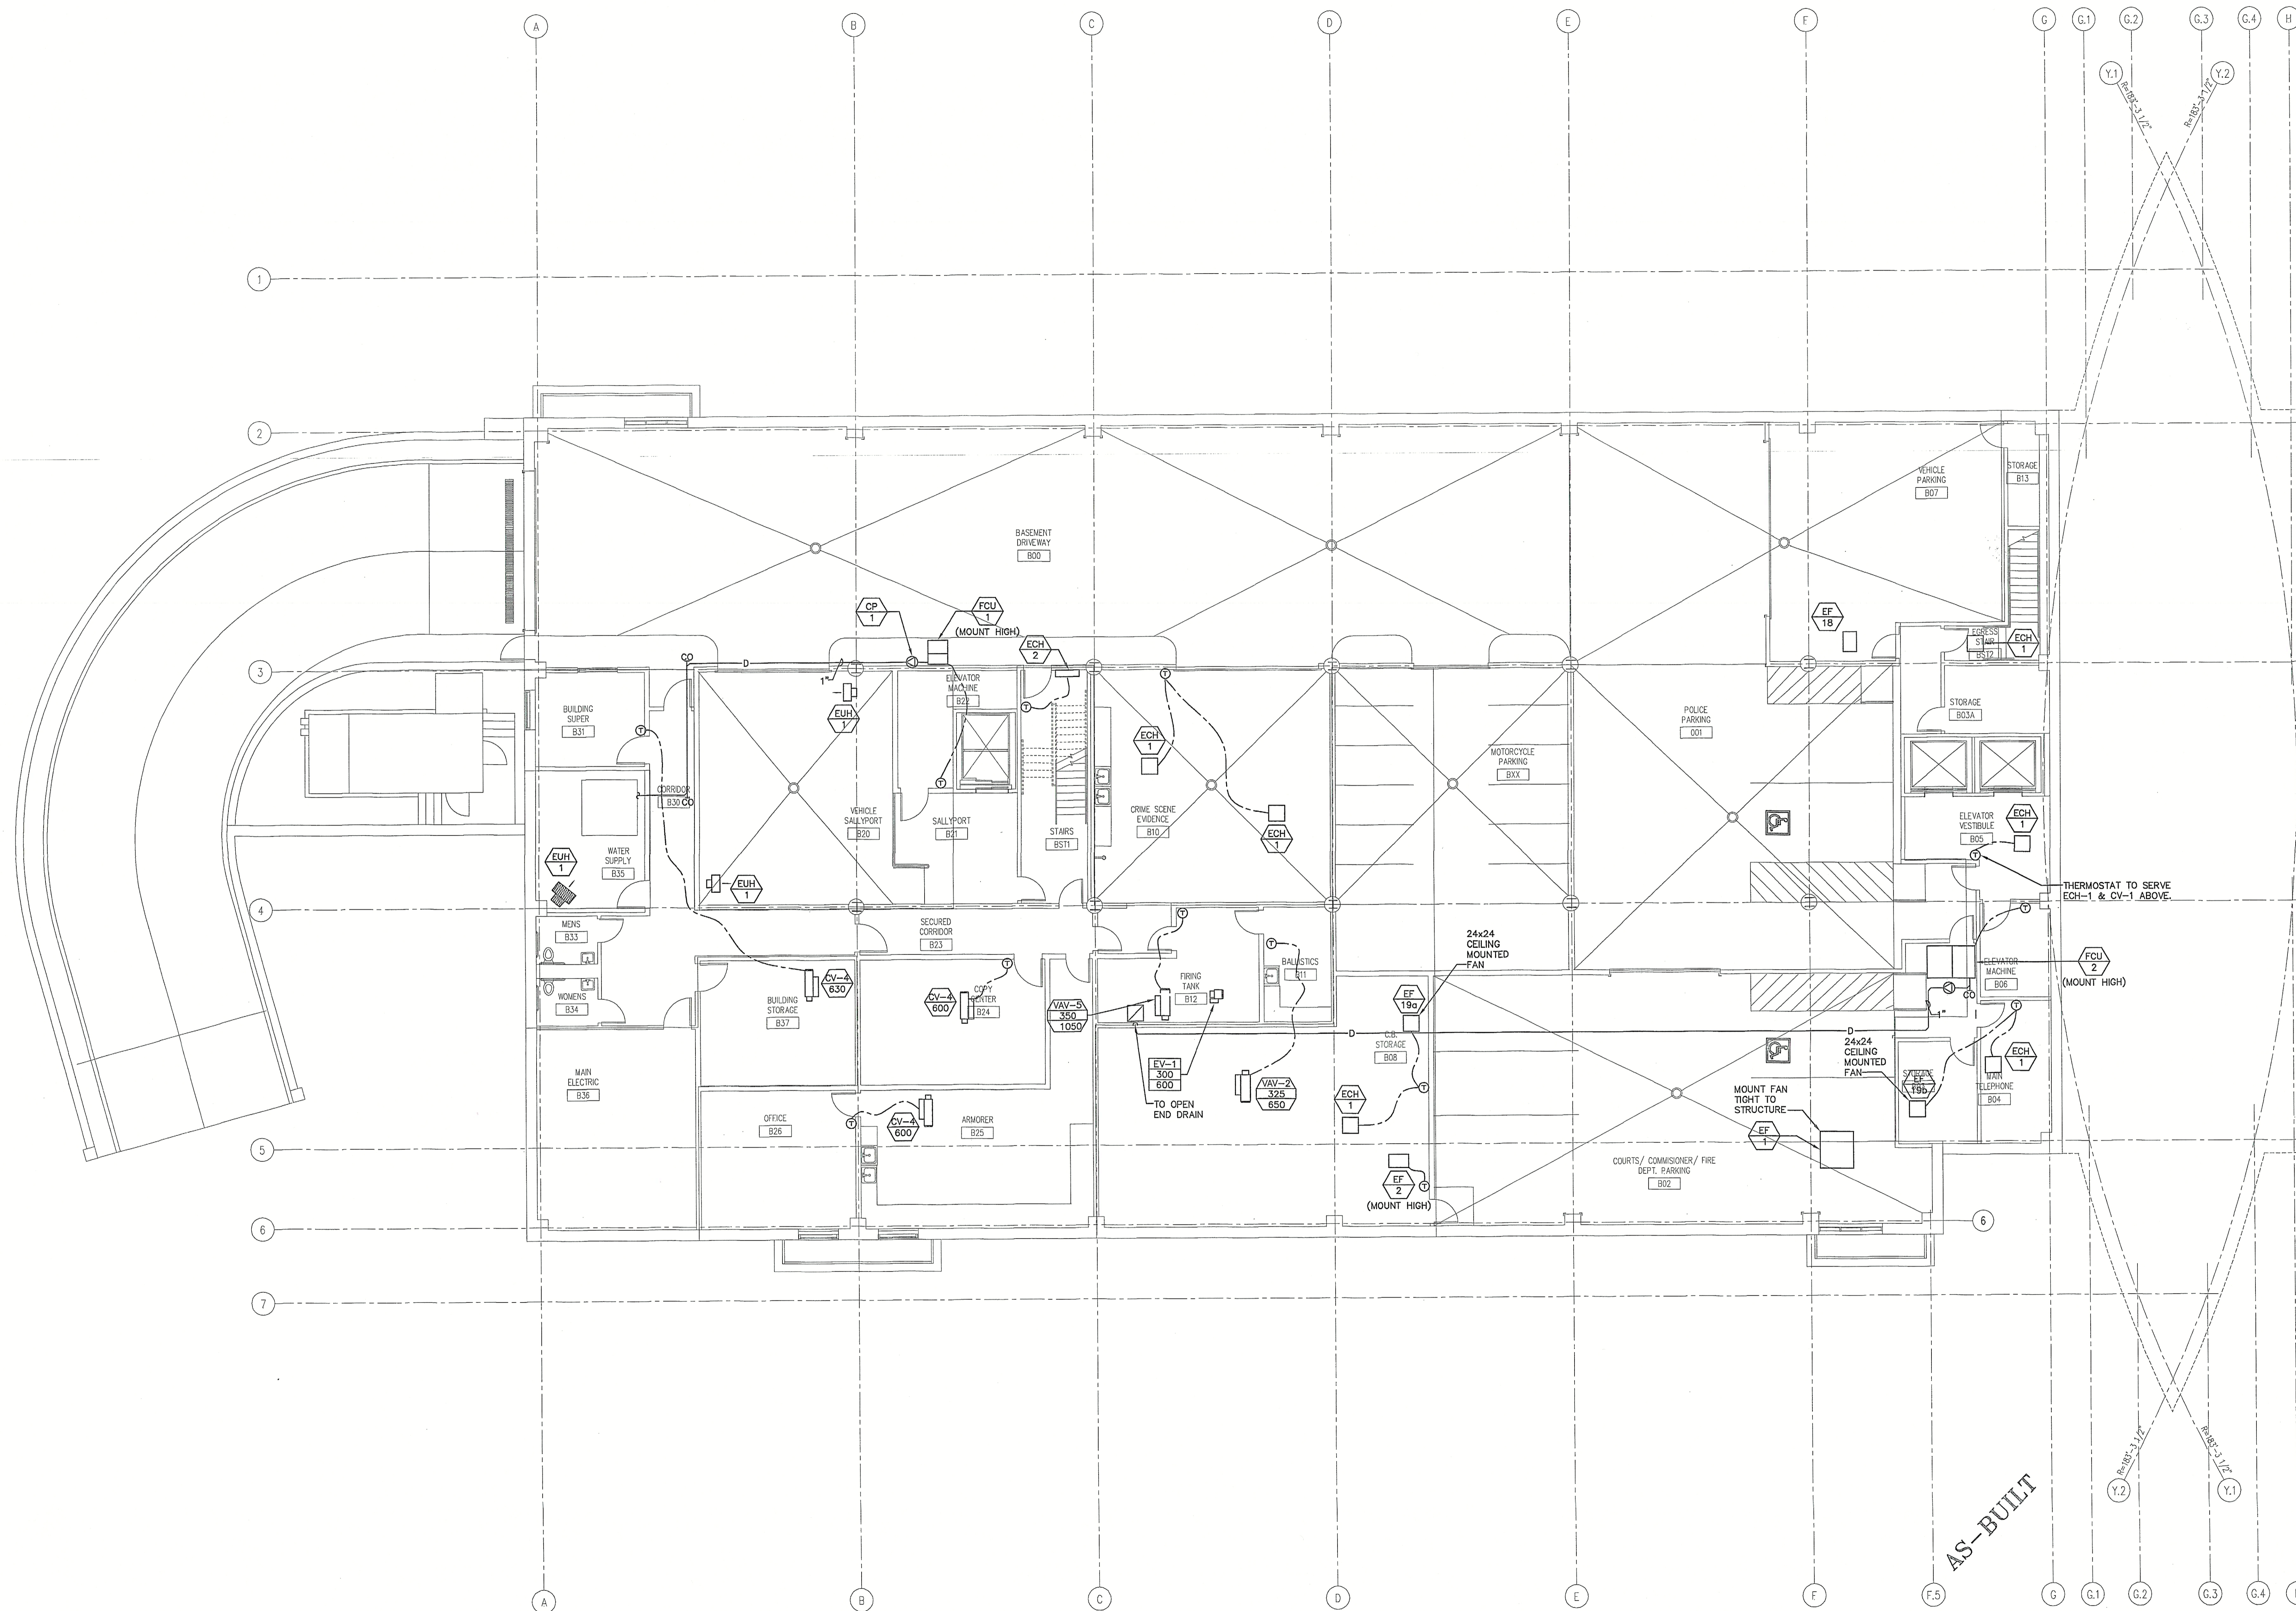

AS-BUILT

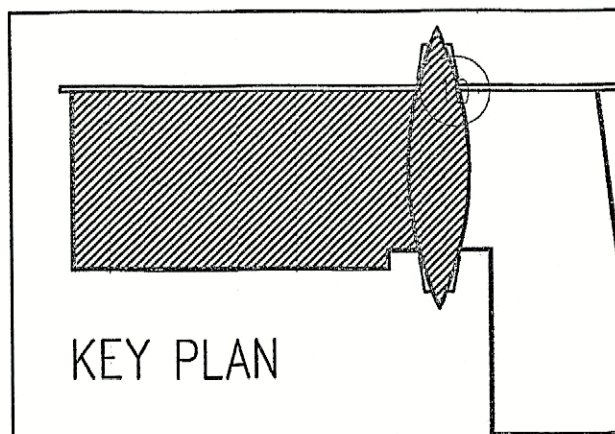

KEY PLAN

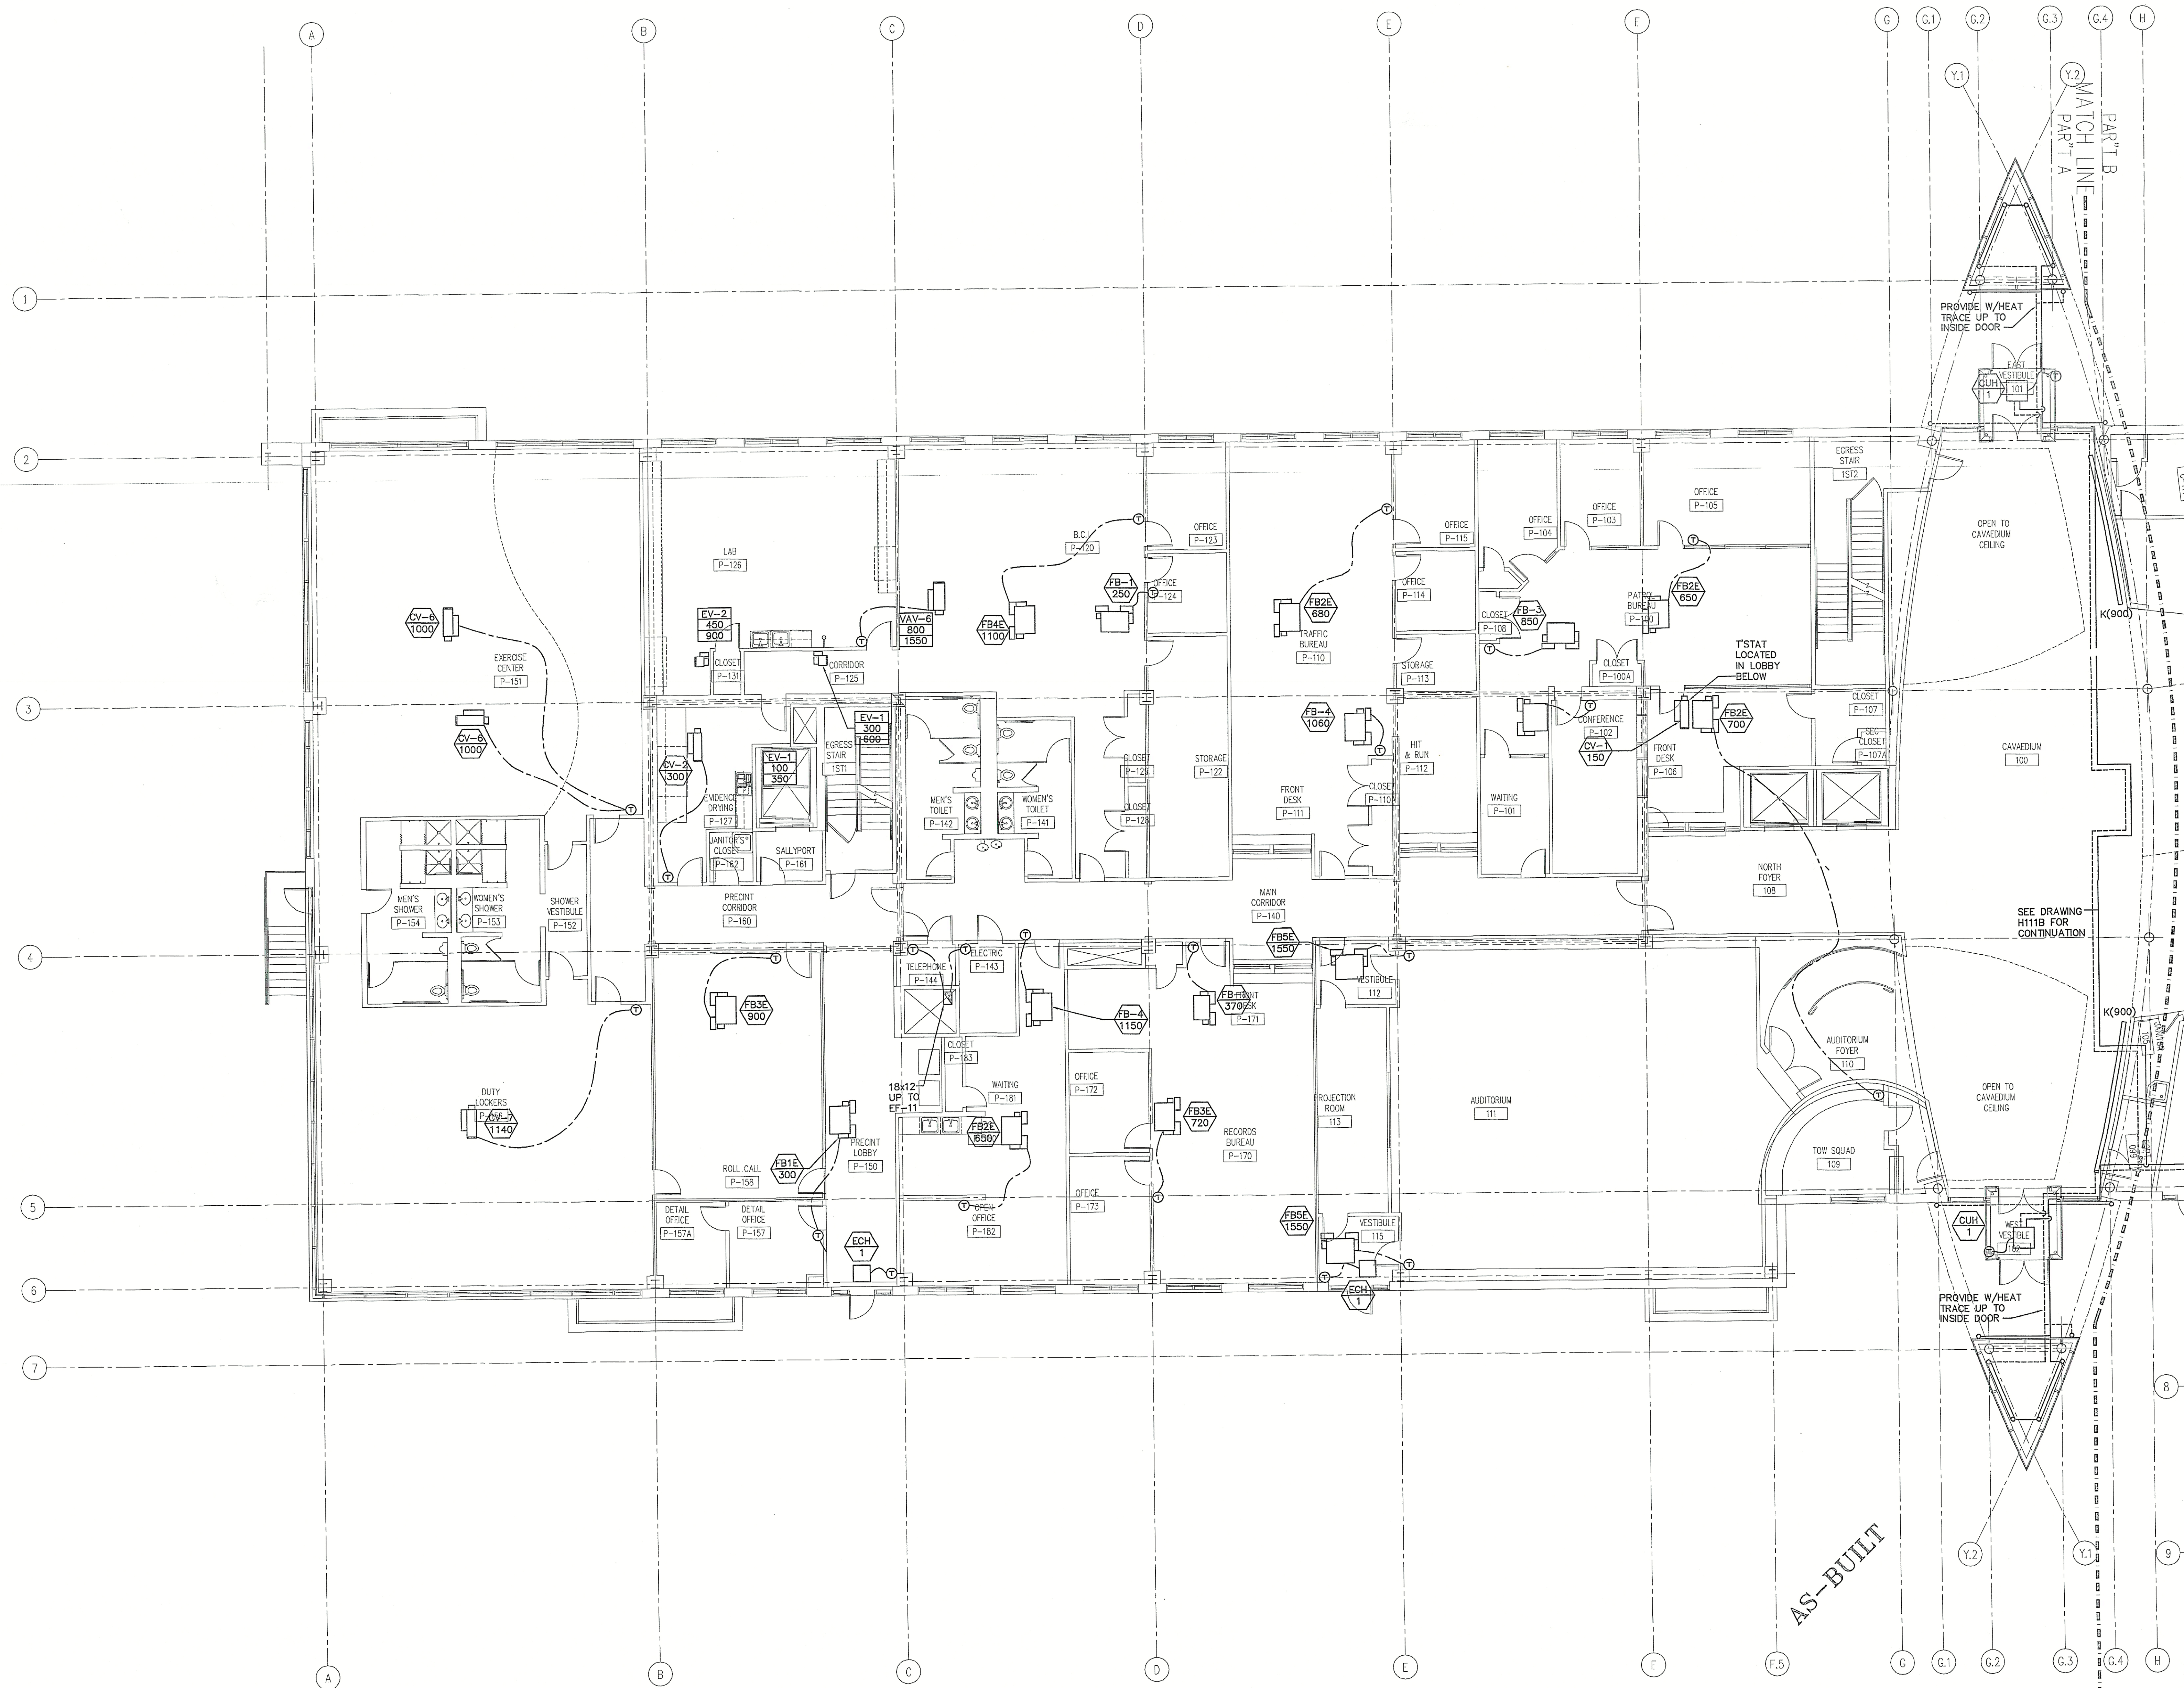


CITY OF PROVIDENCE
PUBLIC SAFETY COMPLEX
PROVIDENCE RI 02903

ADAM
ARDEN ENGINEERING CONSTRUCTORS, INC.
455 NARRAGANSETT PARK DR.
PAWBUCKETT R.I. 02861

PSEG Energy Technologies

TEL: (401) 727-3500
FAX: (401) 727-3540

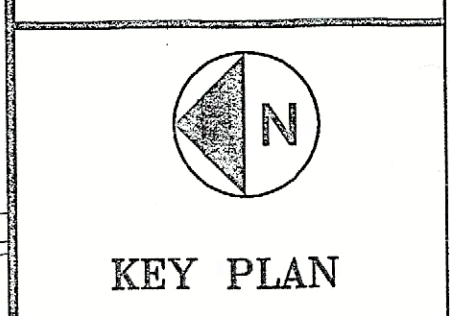

REV.	DATE	DESCRIPTION
1	04/09/02	AS-BUILT

**FIRST FLOOR
POLICE
MECHANICAL
PLAN**

DATE: APRIL 18, 2001
SCALE: 1/8" = 1'-0"
DRAWN BY: BA
CHECKED BY: BA

JOB No. 875
SAP No. F-601
DRAWING No.
M-111A
SHEET 1

AS-BUILT

KEY PLAN



TEL: (401) 727-3500
FAX: (401) 727-3540



KEY PLAN


REV.	DATE	DESCRIPTION
1	04/08/02	AS-BUILT

FIRST FLOOR
FIRE / COURTS
MECHANICAL
PLAN
DATE: APRIL 18, 2001
SCALE: 1/8" = 1'-0"
DRAWN BY: BA
CHECKED:


JOB No. 875
SAP No. E-601
DRAWING No.

M-111B

SHEET 1

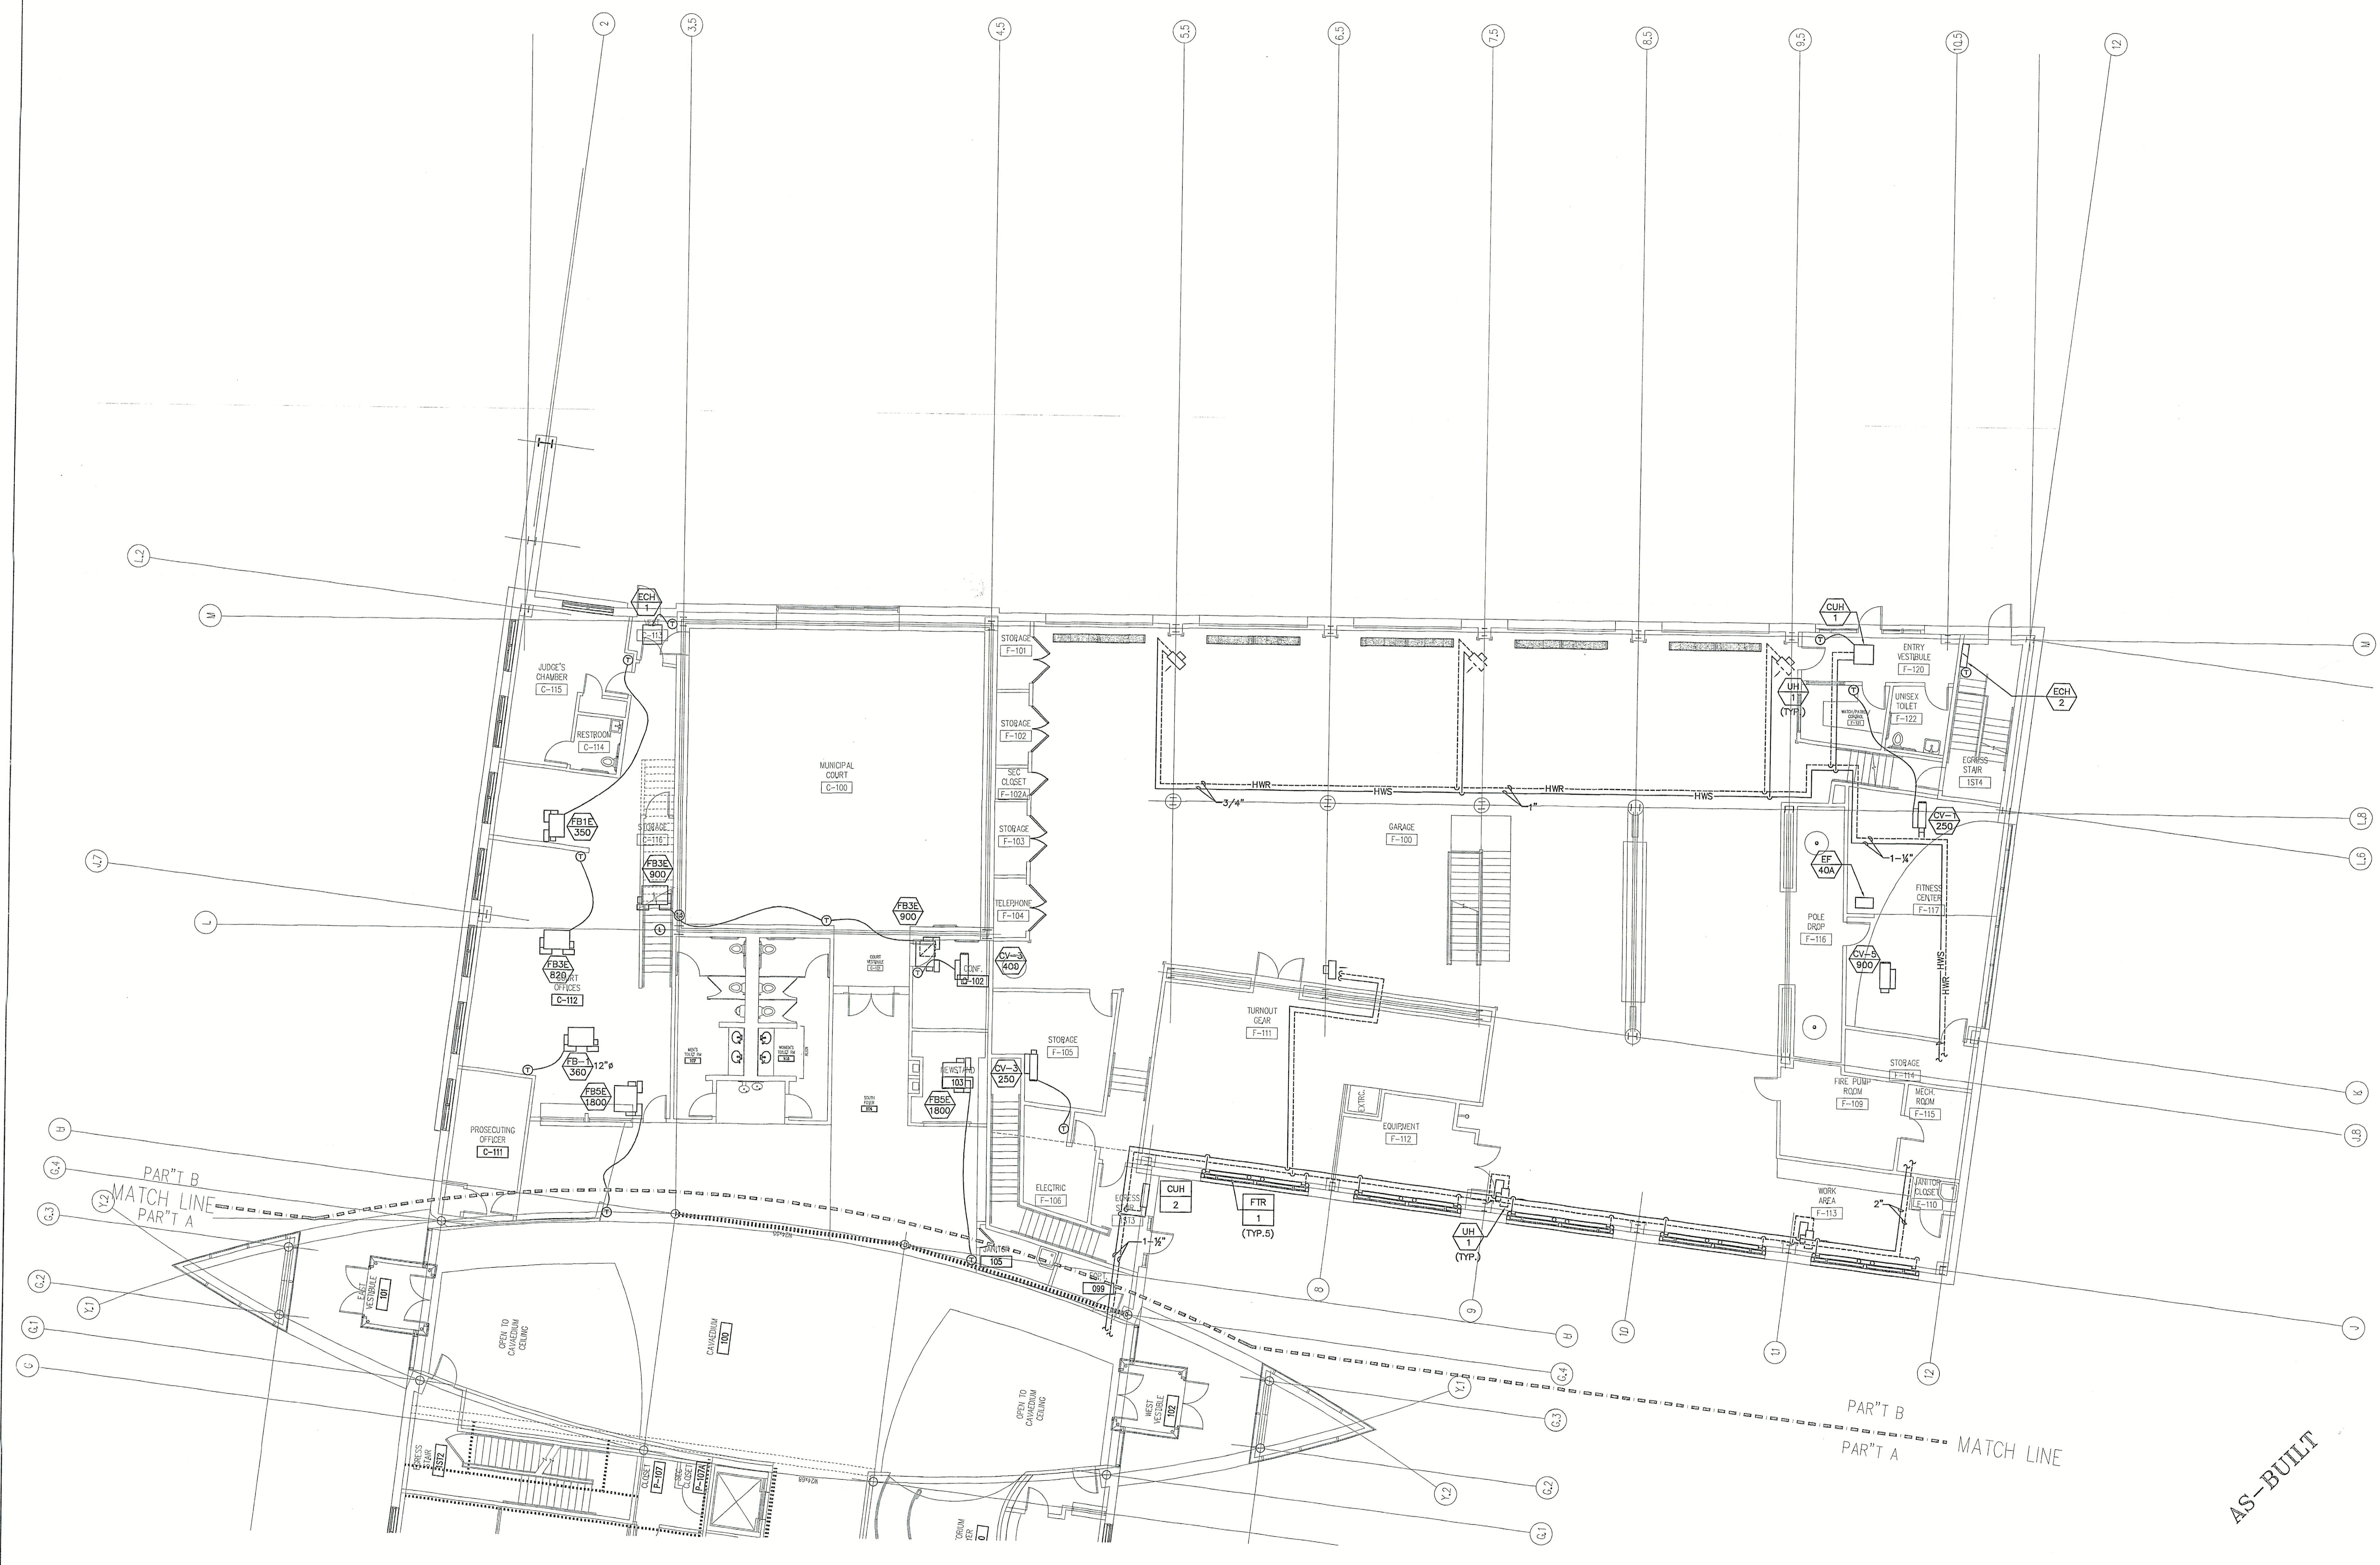

AS-BUILT

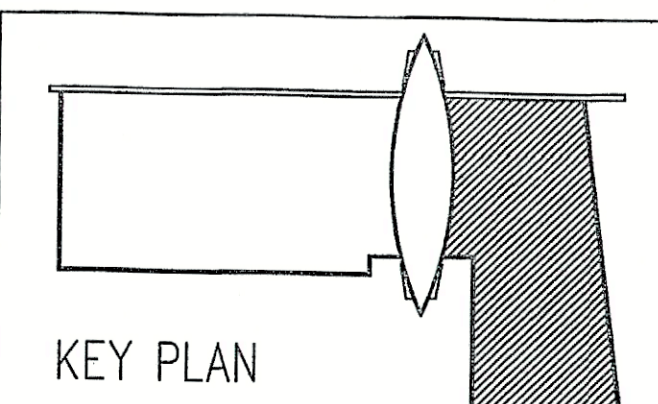


KEY PLAN

REV.	DATE	DESCRIPTION
1	04/08/02	AS-BUILT



DATE	SCALE	DRAWN	CHECKED
APRIL 25, 2001	1/8" = 1'-0"	DAW	RA

JOB No. 875	SAR No. P-601
DRAWING No.	
M-112A	
SHEET 1	

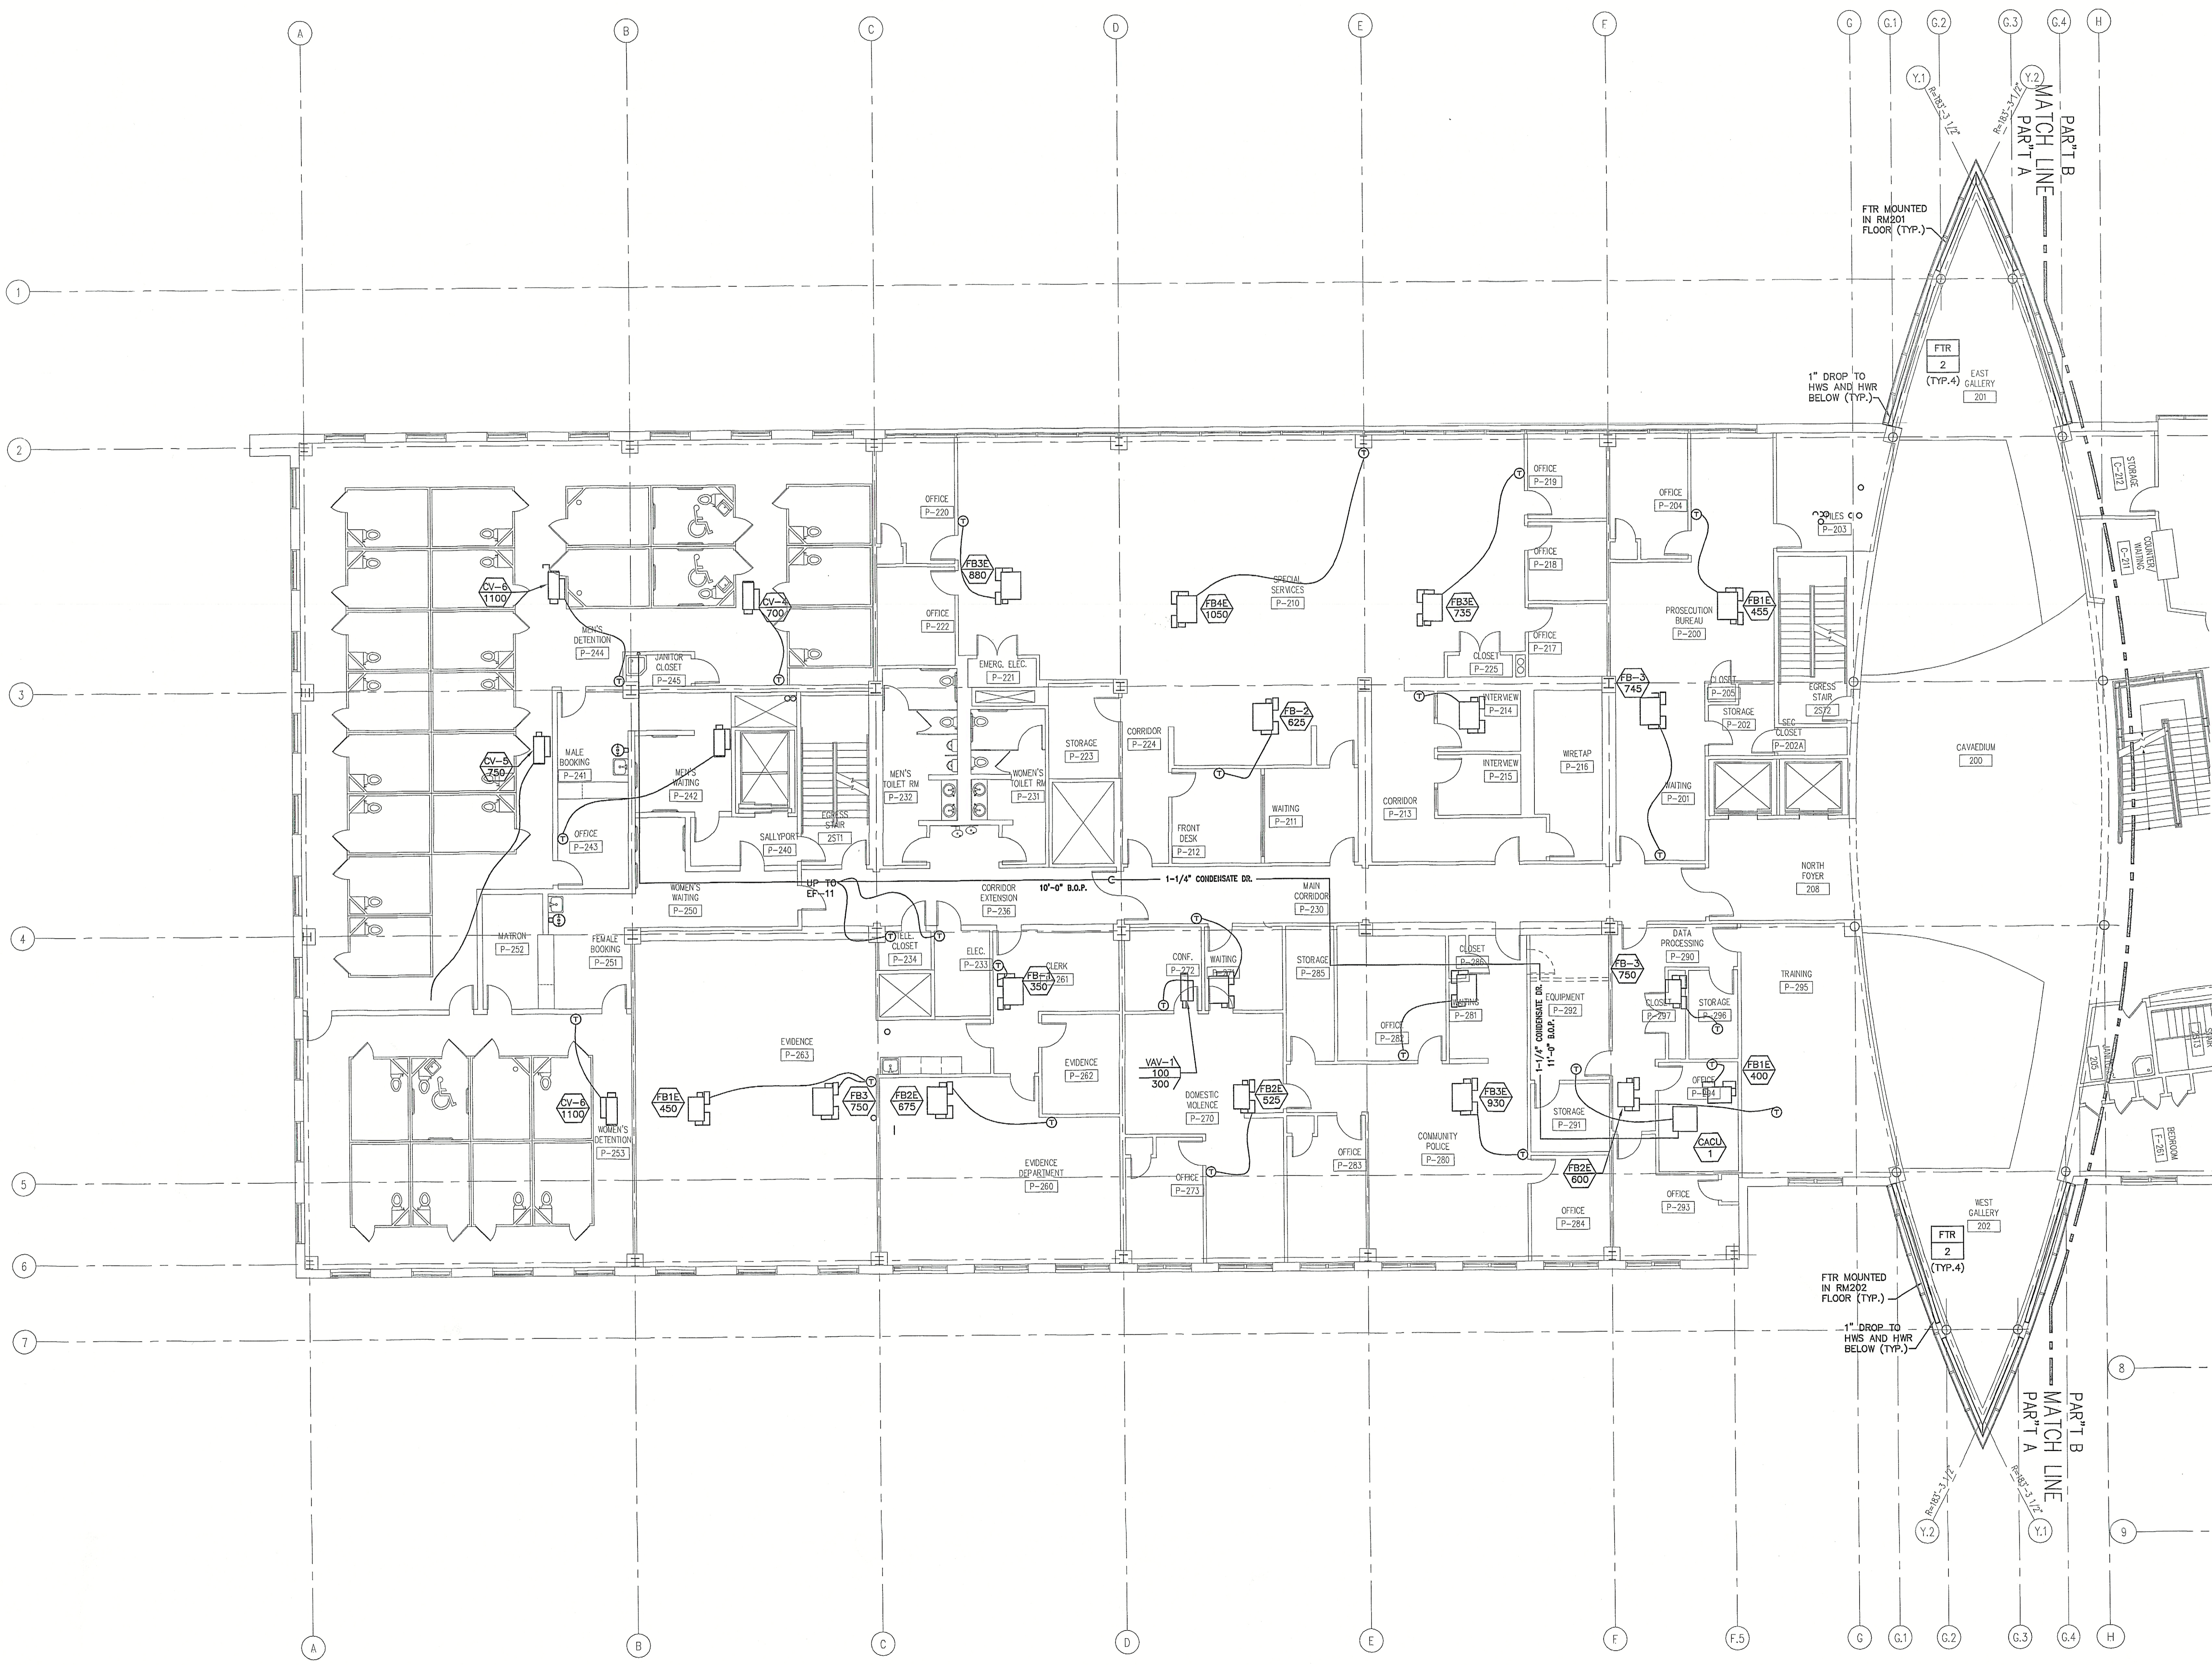

AS-BUILT

KEY PLAN

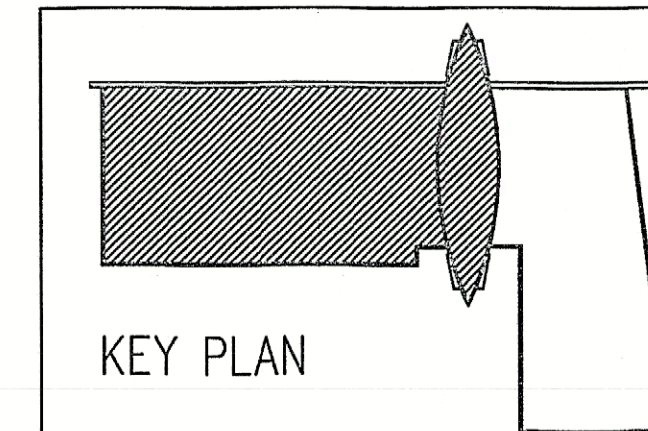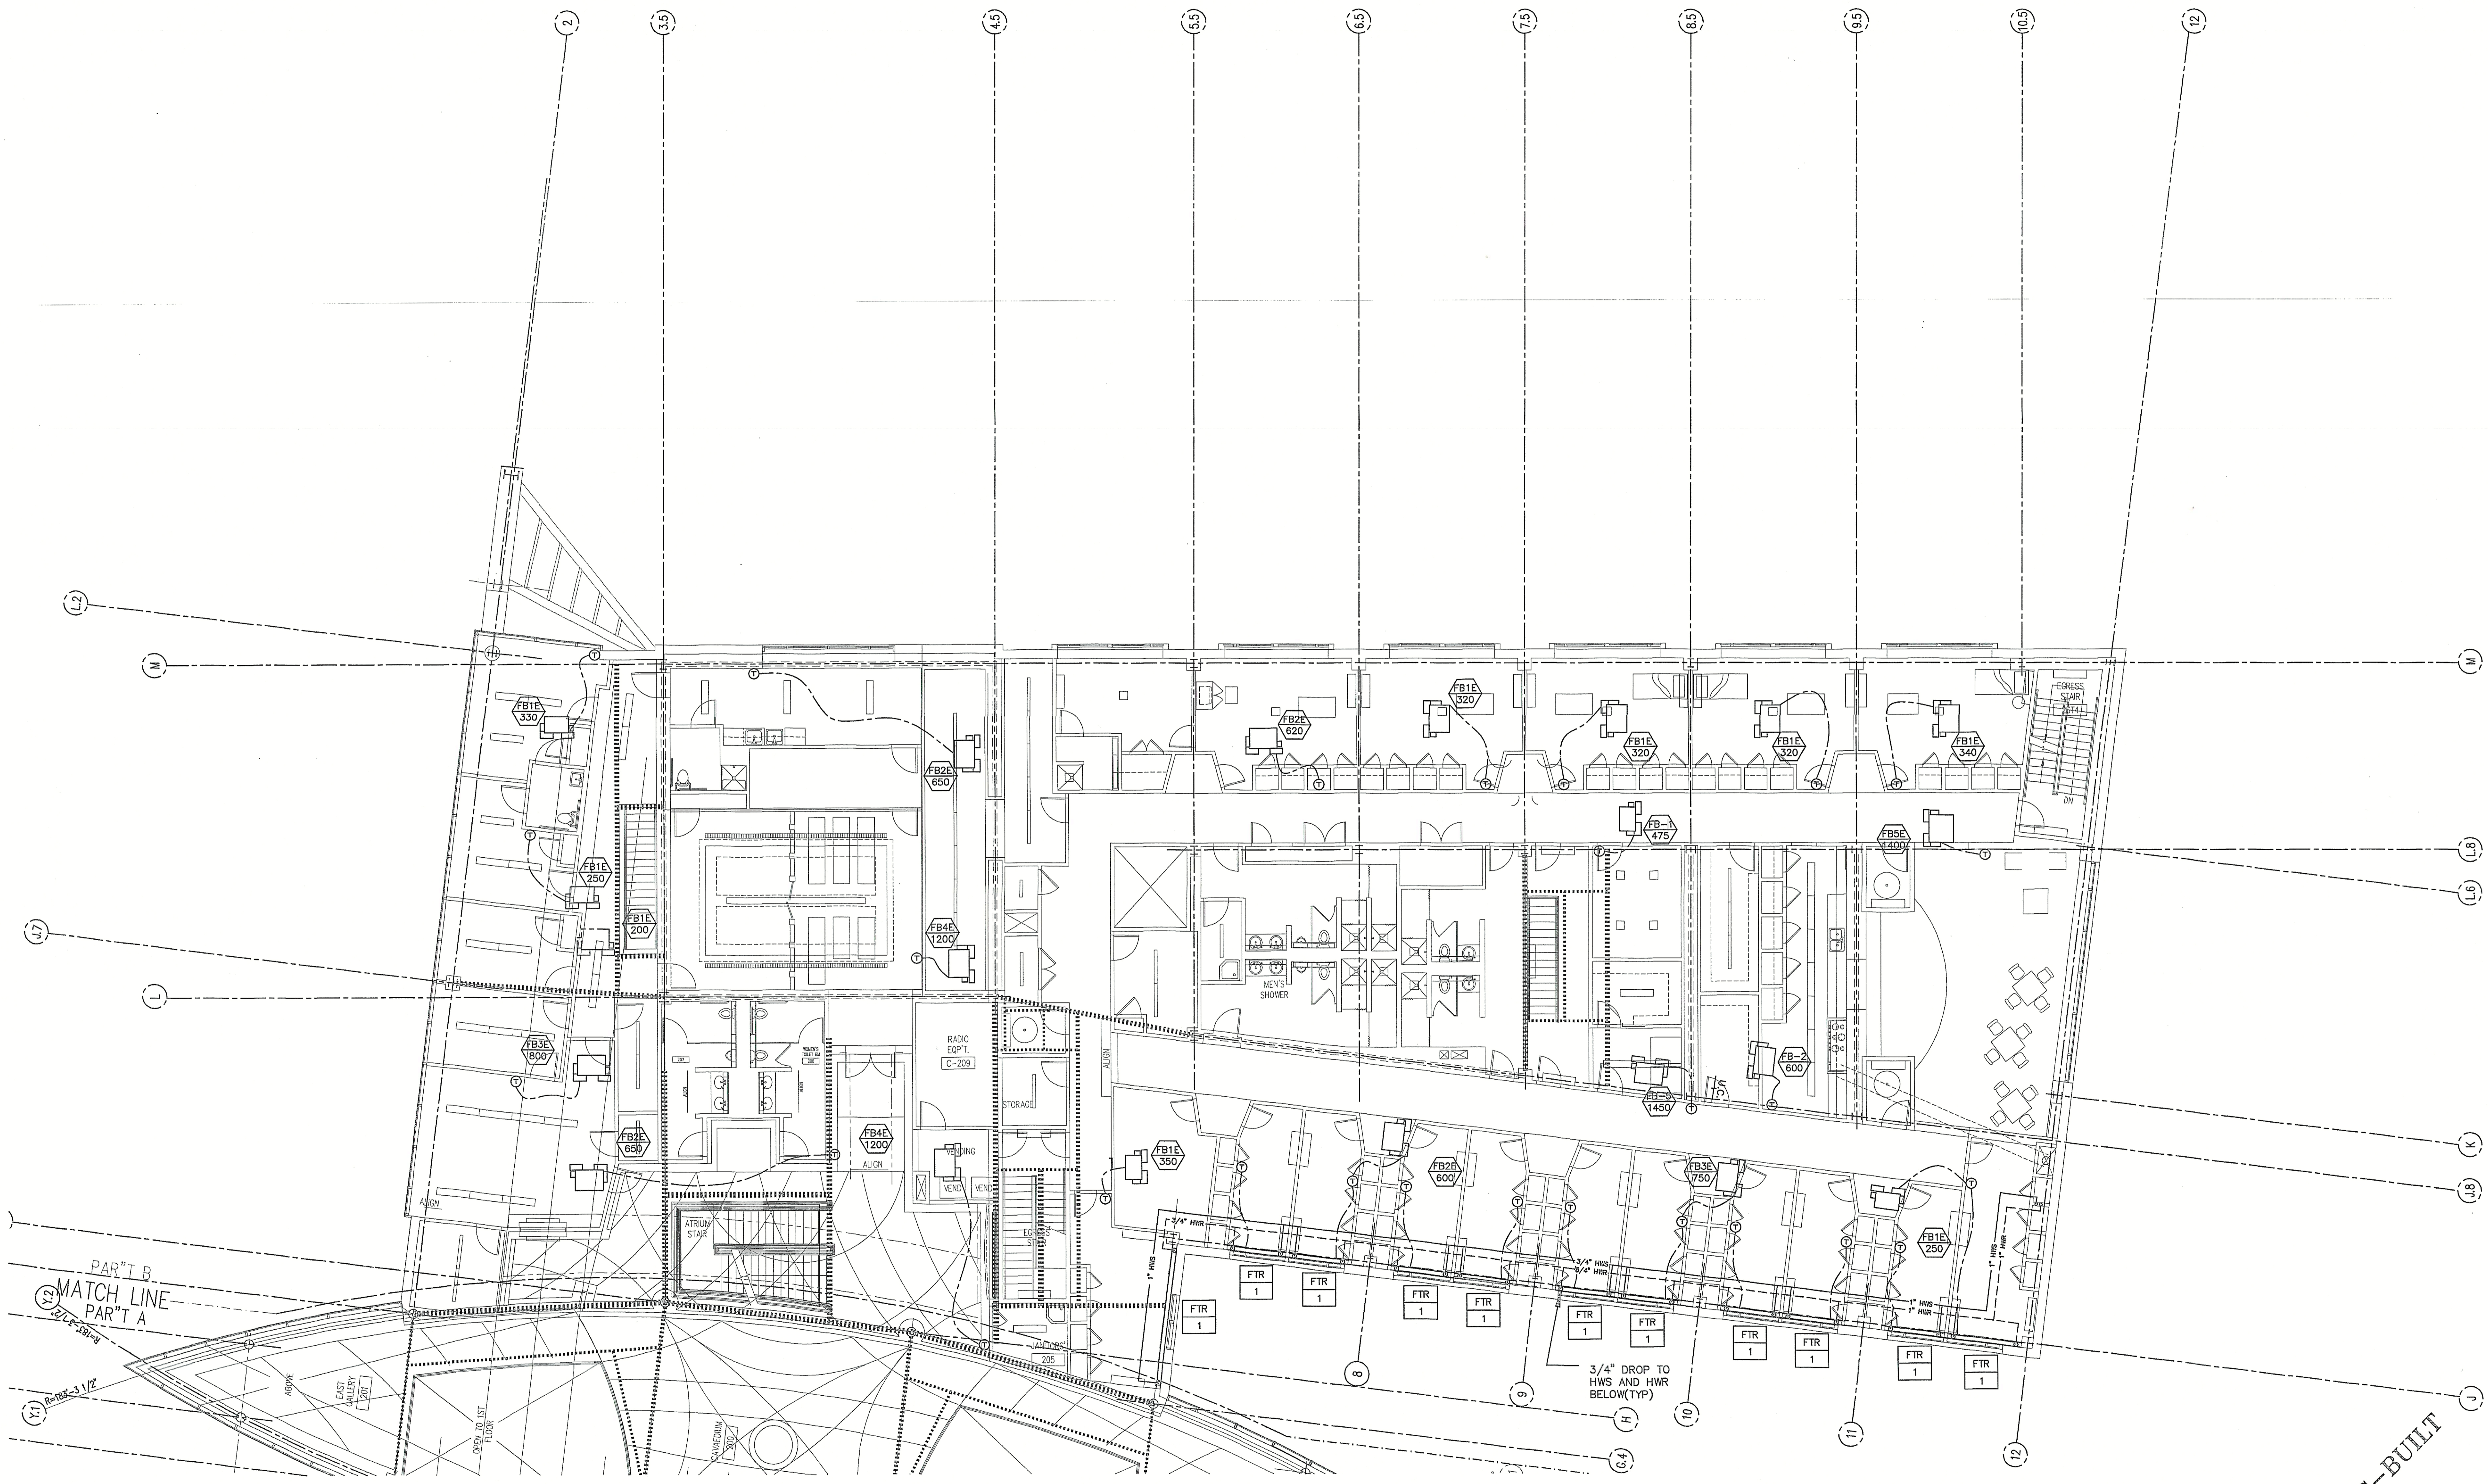

CITY OF PROVIDENCE
PUBLIC SAFETY COMPLEX
PROVIDENCE RI 02903

ARDEN
ARDEN ENGINEERING CONSTRUCTORS, INC.
435 PANTUCKET BL. 02881
PSEG Energy Technologies

TEL: (401) 727-3500
FAX: (401) 727-3500

KEY PLAN


REV.	DATE	DESCRIPTION
1	04/08/02	AS-BUILT

SECOND FLOOR
FIRE / COURTS
MECHANICAL
PLAN
DATE: APRIL 25, 2001 SCALE: 1/8" = 1'-0" DRAWN: DAW BA CHECKED:

JOB No. 875
SAP No. E-601
DRAWING No.

M-112B


SHEET 1

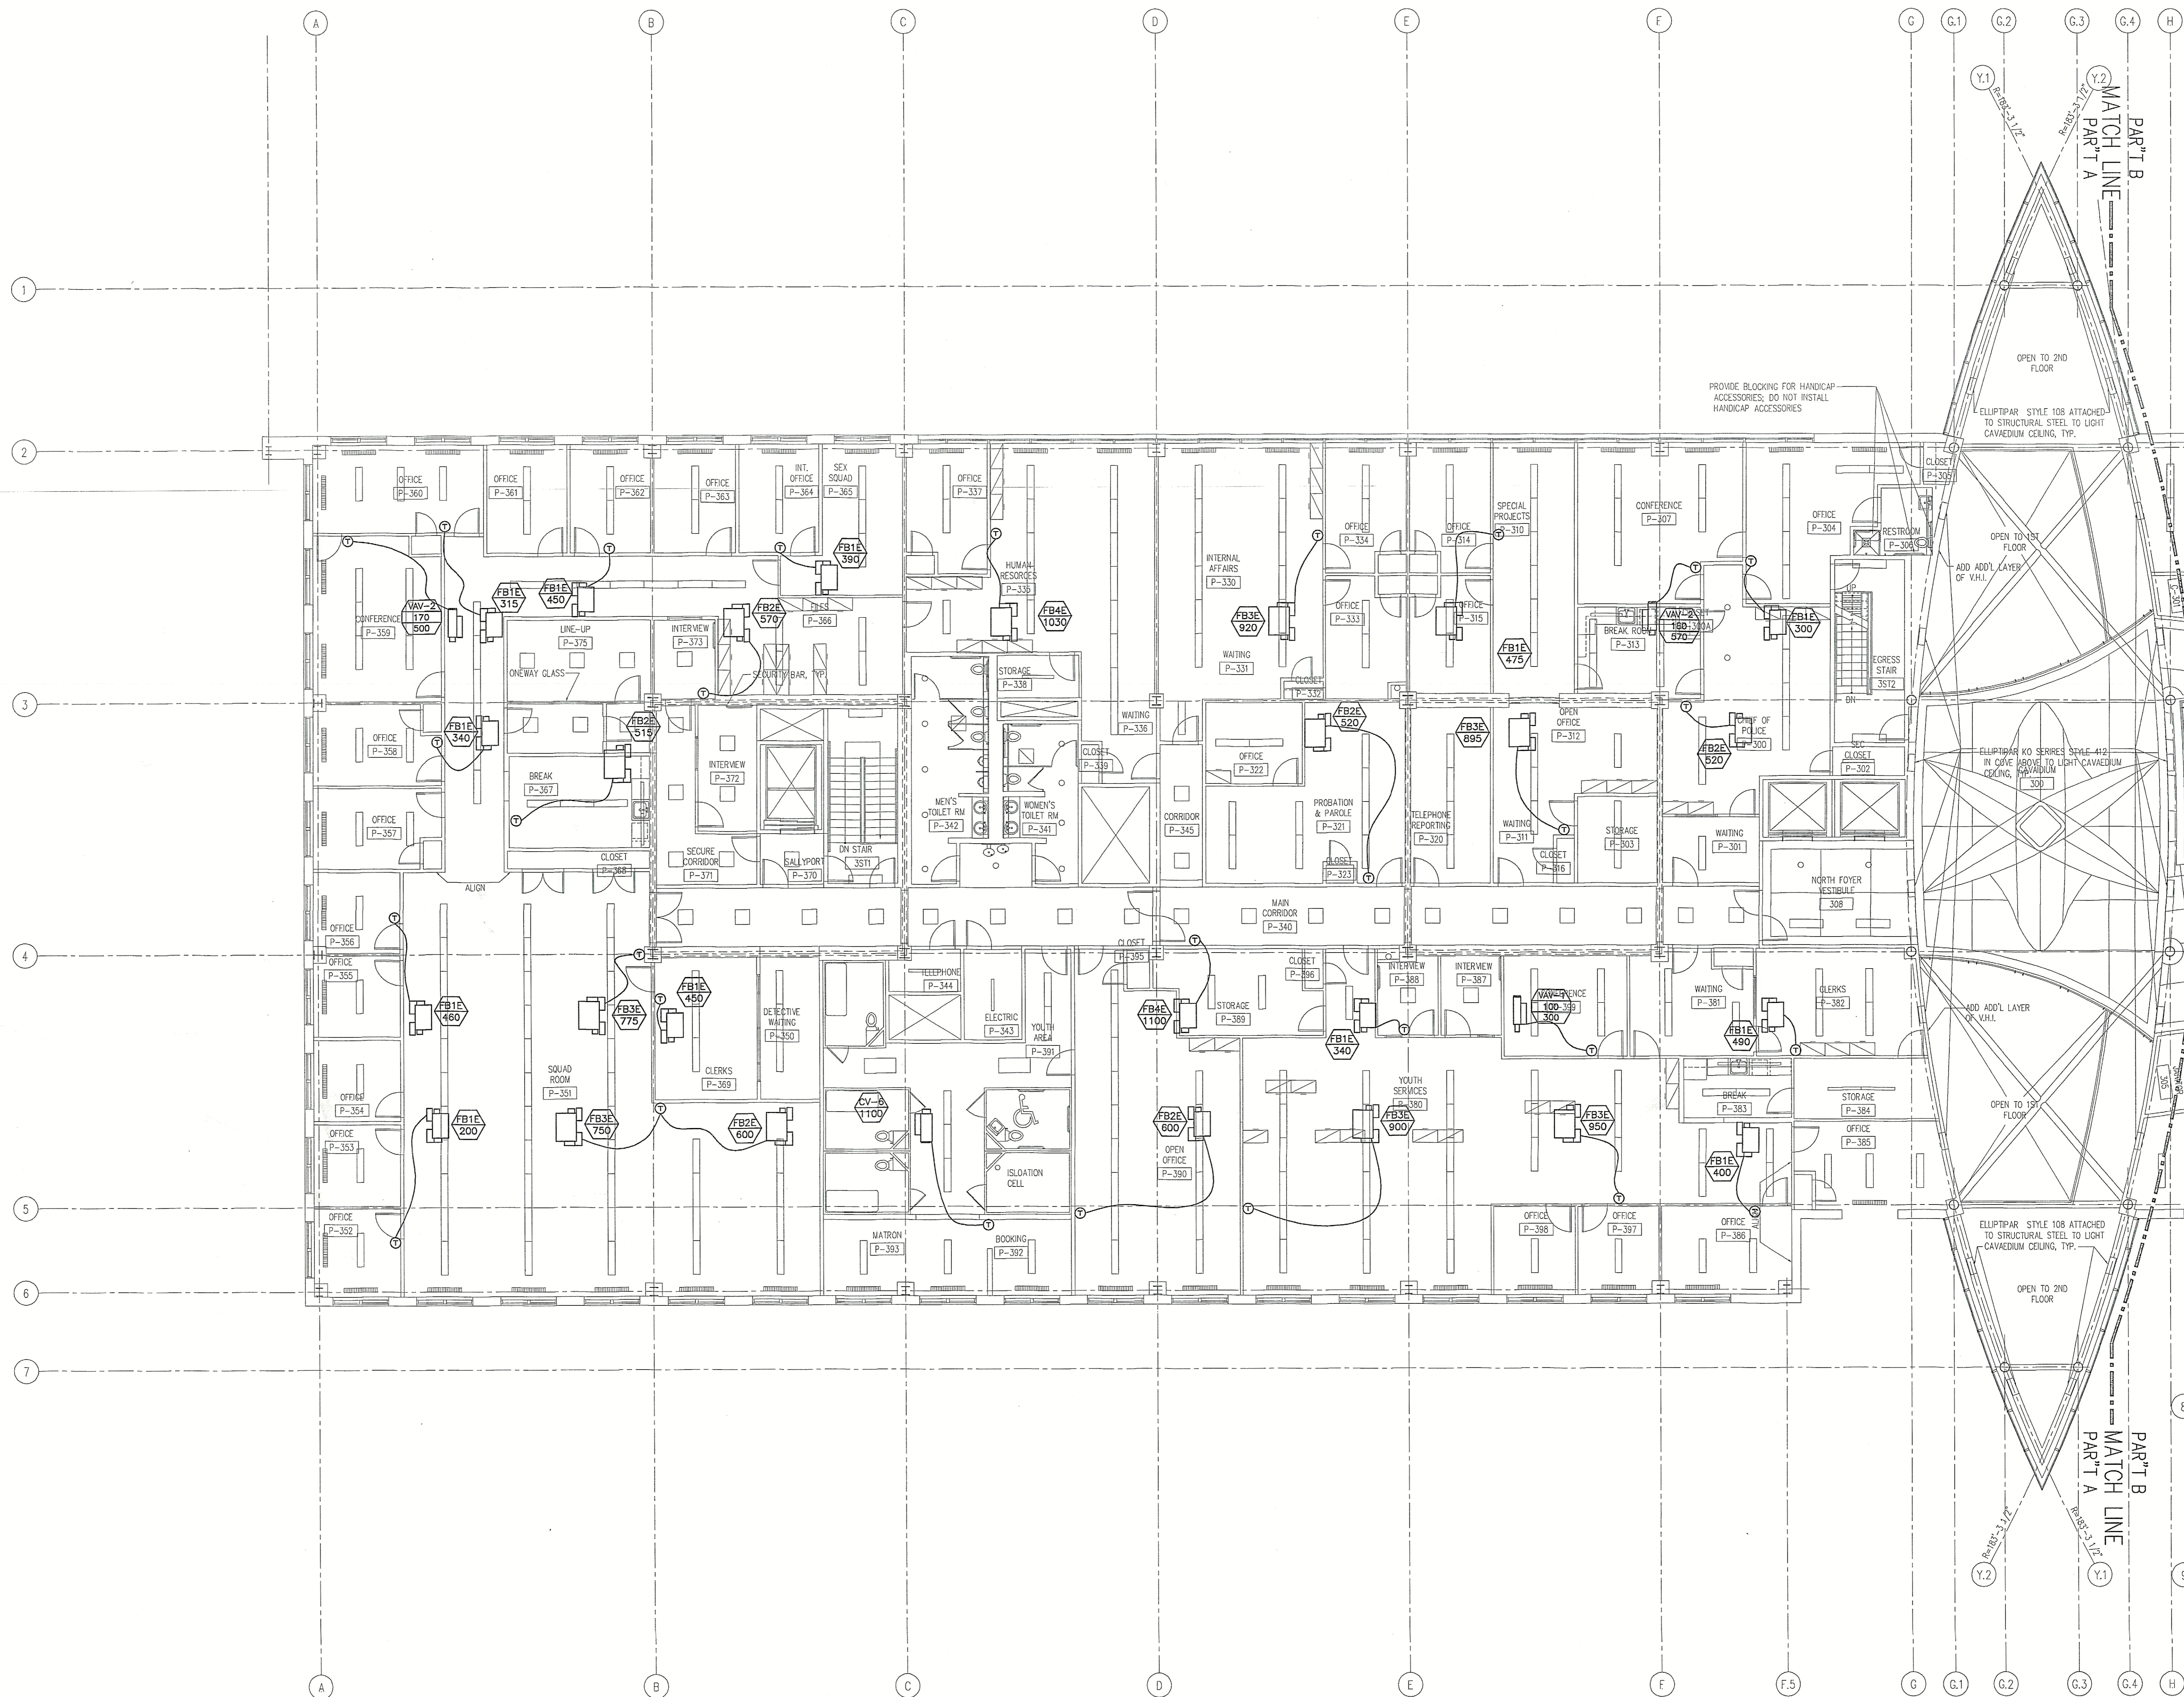


REV.	DATE	DESCRIPTION
1	04/08/02	AS-BUILT

DATE	SCALE	DRAWN	CHECKED

AS-BUILT

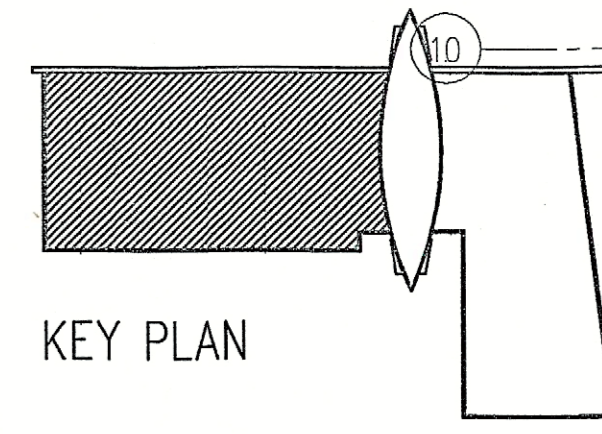

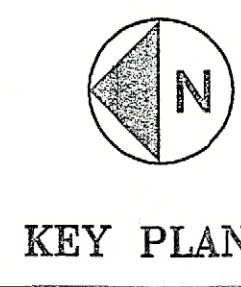

KEY PLAN



REV.	DATE	DESCRIPTION
1	04/08/02	AS-BUILT

THIRD FLOOR
FIRE/COURTS
MECHANICAL
PLAN

JOB No. 875
SAP No. E-601
DRAWING No.

H-113B

SHEET 1

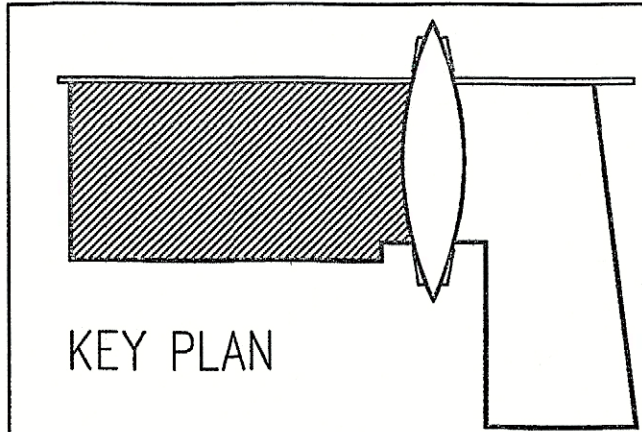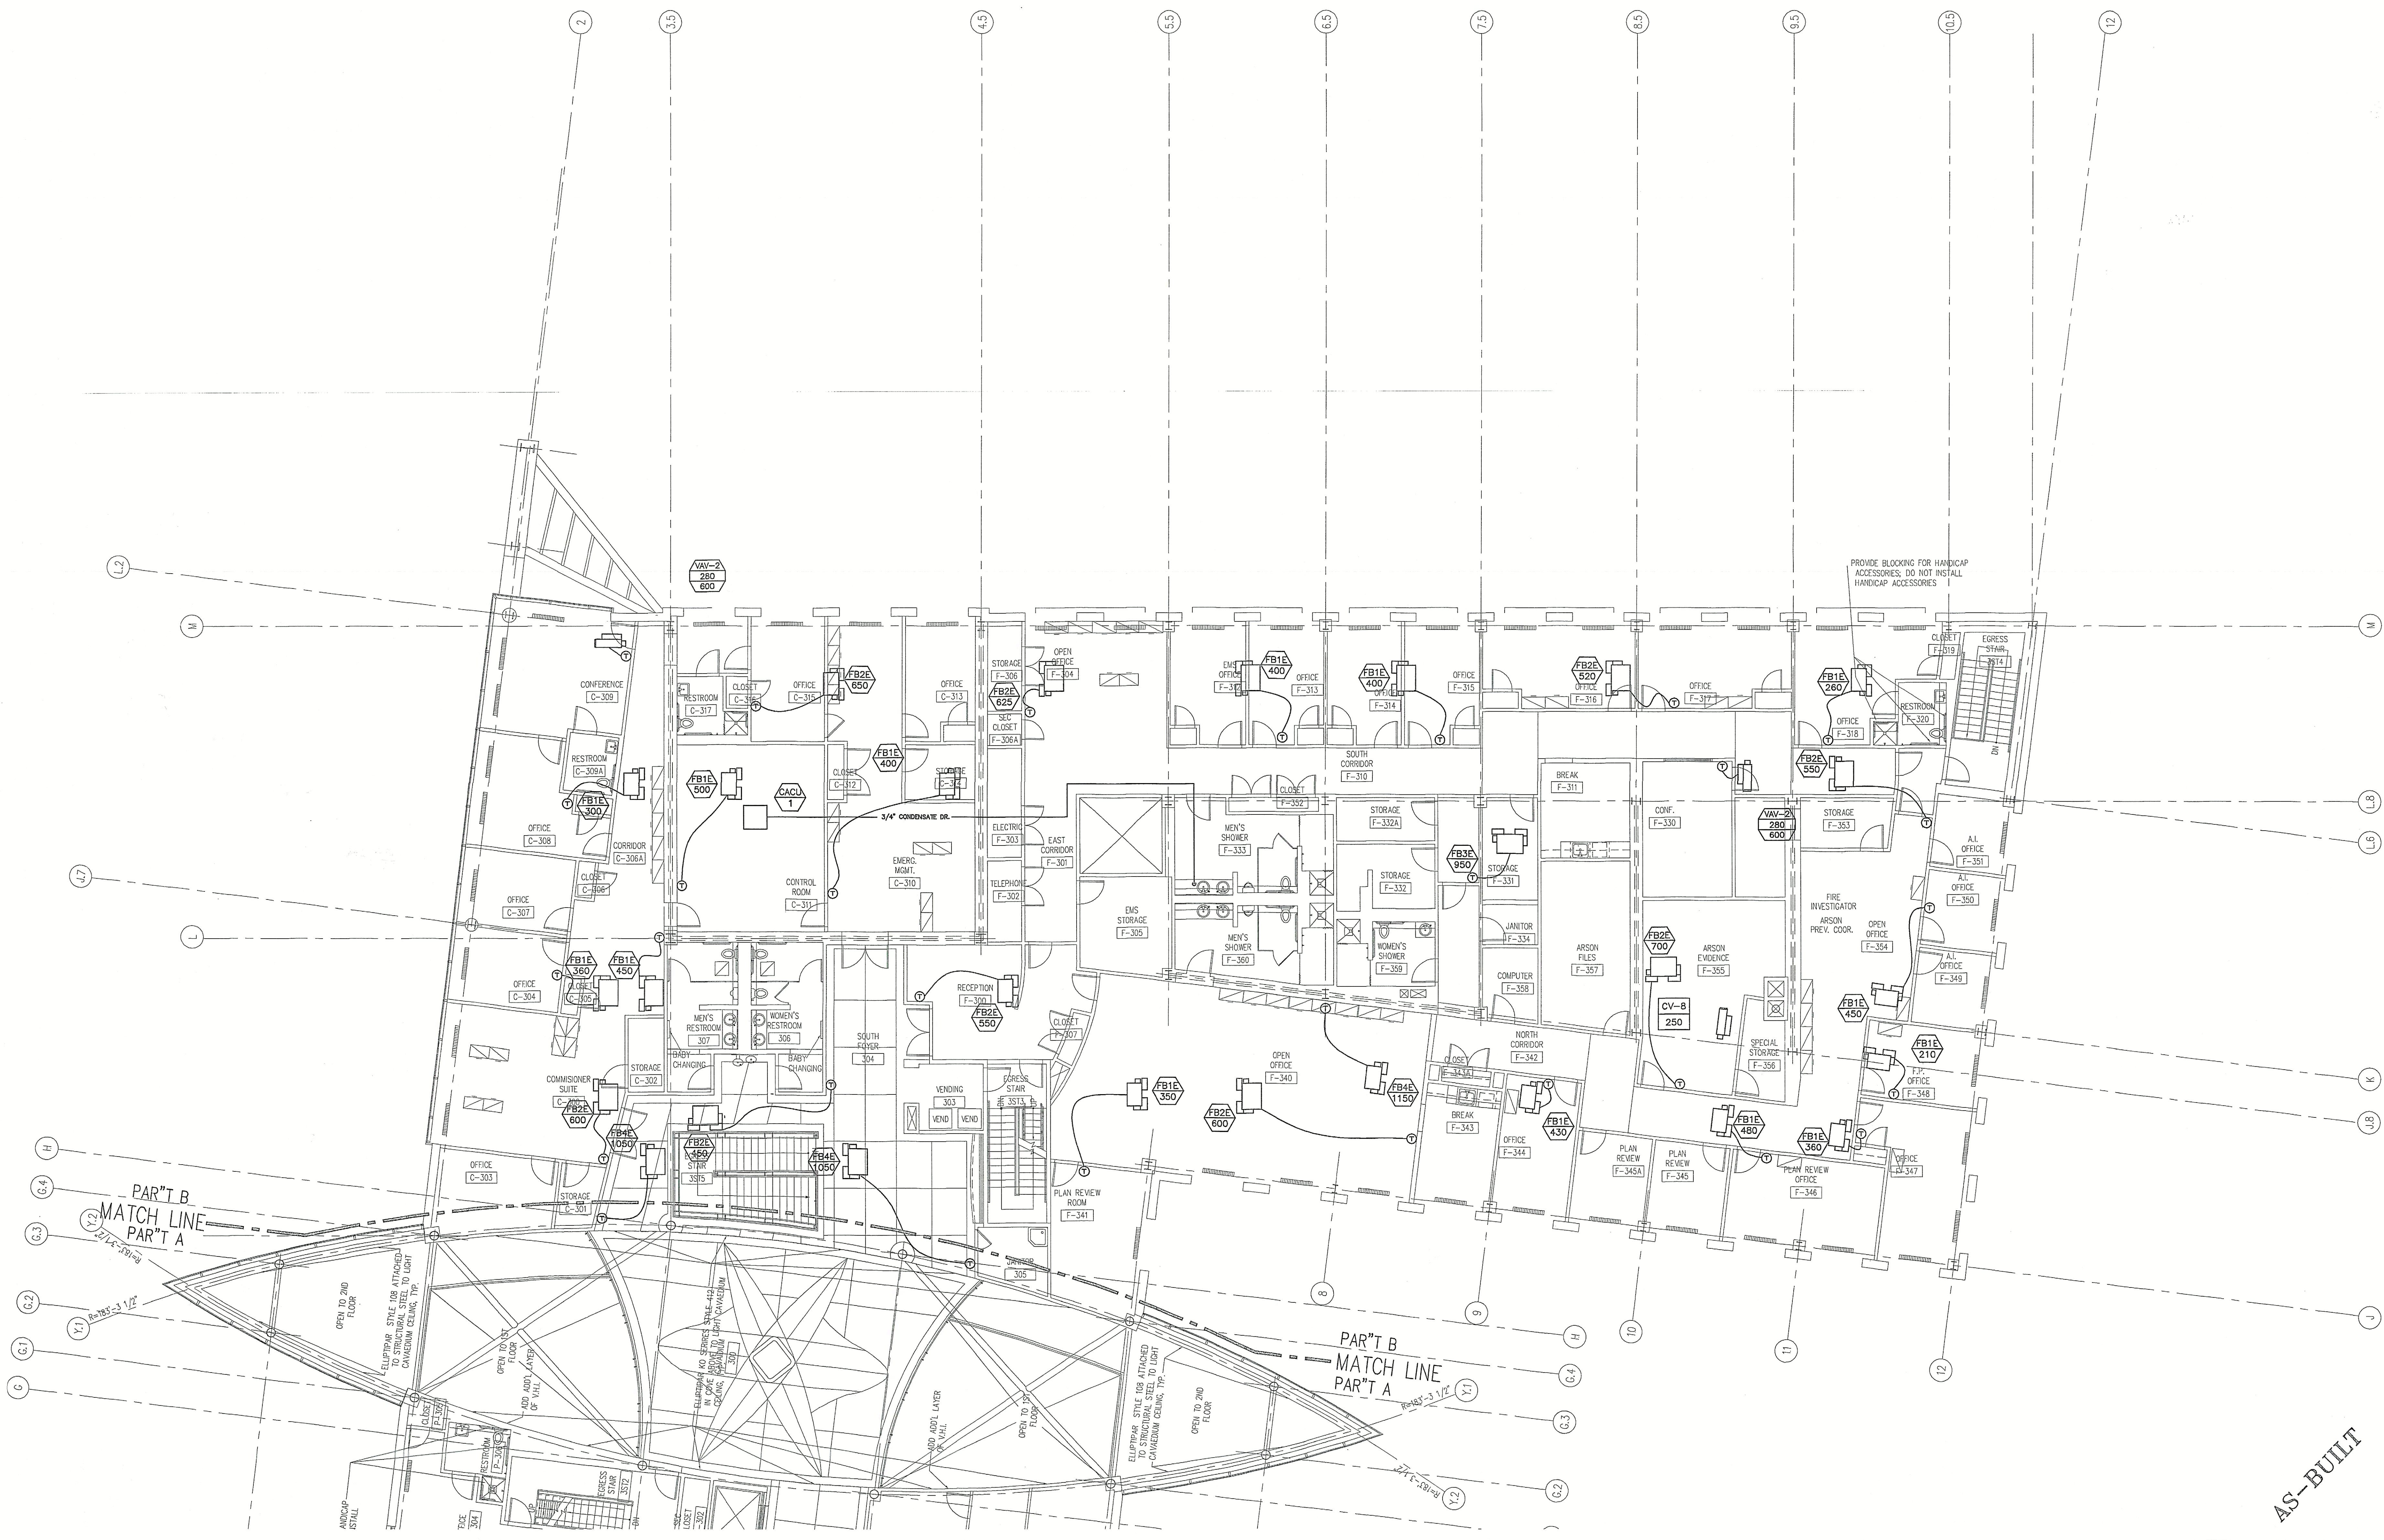

AS-BUILT